
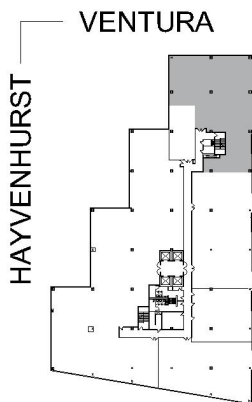


16501 VENTURA

SUITE 610 | 5,396 RSF
SHERMAN OAKS/ENCINO

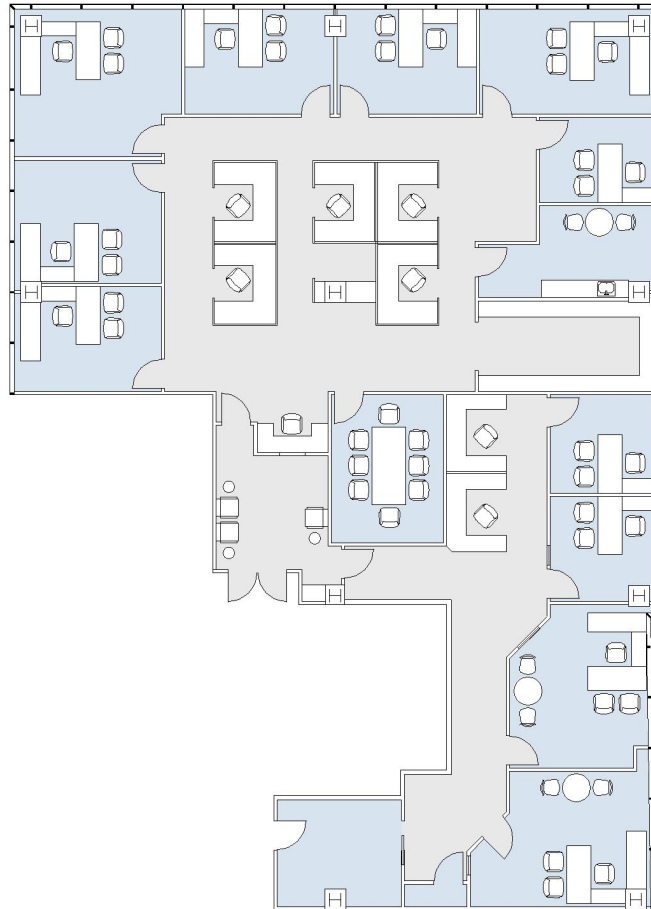

AS-BUILT CONFIGURATION

OFFICES:	11
CONFERENCE ROOM:	1
RECEPTION:	1
STORAGE:	1
CLOSET:	1

NOT TO SCALE
FURNITURE NOT INCLUDED

For more information, please contact:

310.255.7777
leasing@douglasemmett.com

**Douglas
Emmett**