
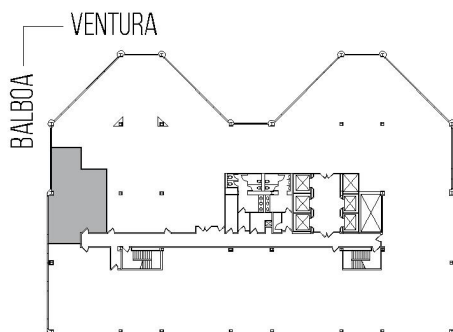


16830 VENTURA

FIRST FINANCIAL PLAZA

SUITE 515 | 1,180 RSF

SHERMAN OAKS/ENCINO

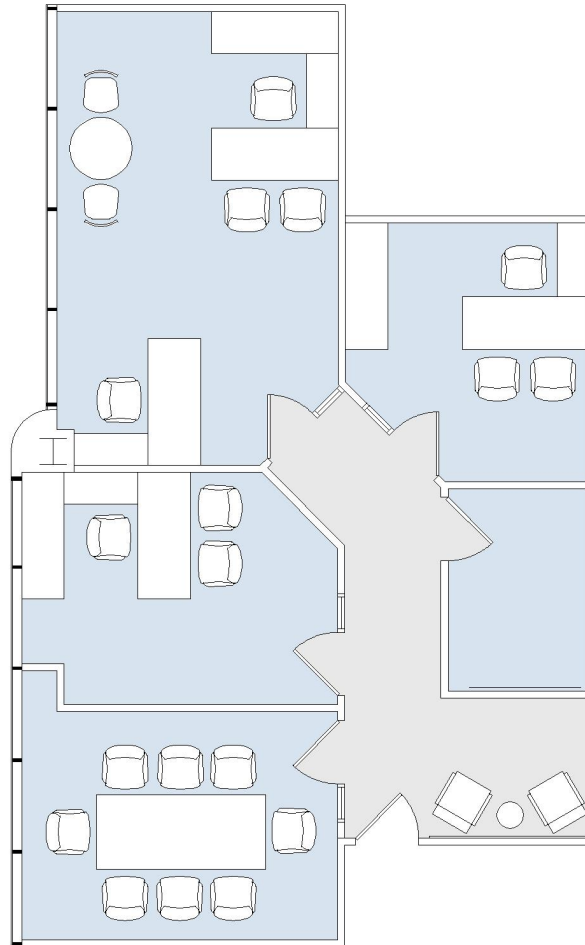

AS-BUILT CONFIGURATION

OFFICES:	3
CONFERENCE ROOM:	1
STORAGE / IT ROOM:	1

NOT TO SCALE
FURNITURE NOT INCLUDED

For more information, please contact:

310.255.7777

leasing@douglasemmett.com

**Douglas
Emmett**