



# 12011

SALTAIR/SAN VICENTE

SUITE 350 | 1,952 RSF

BRENTWOOD-SAN VICENTE

## SAN VICENTE

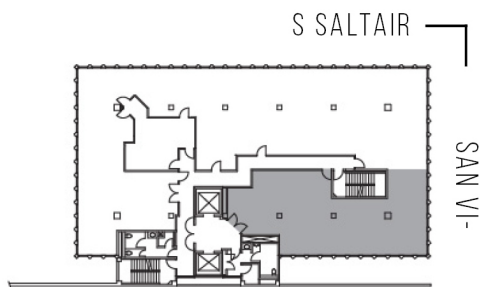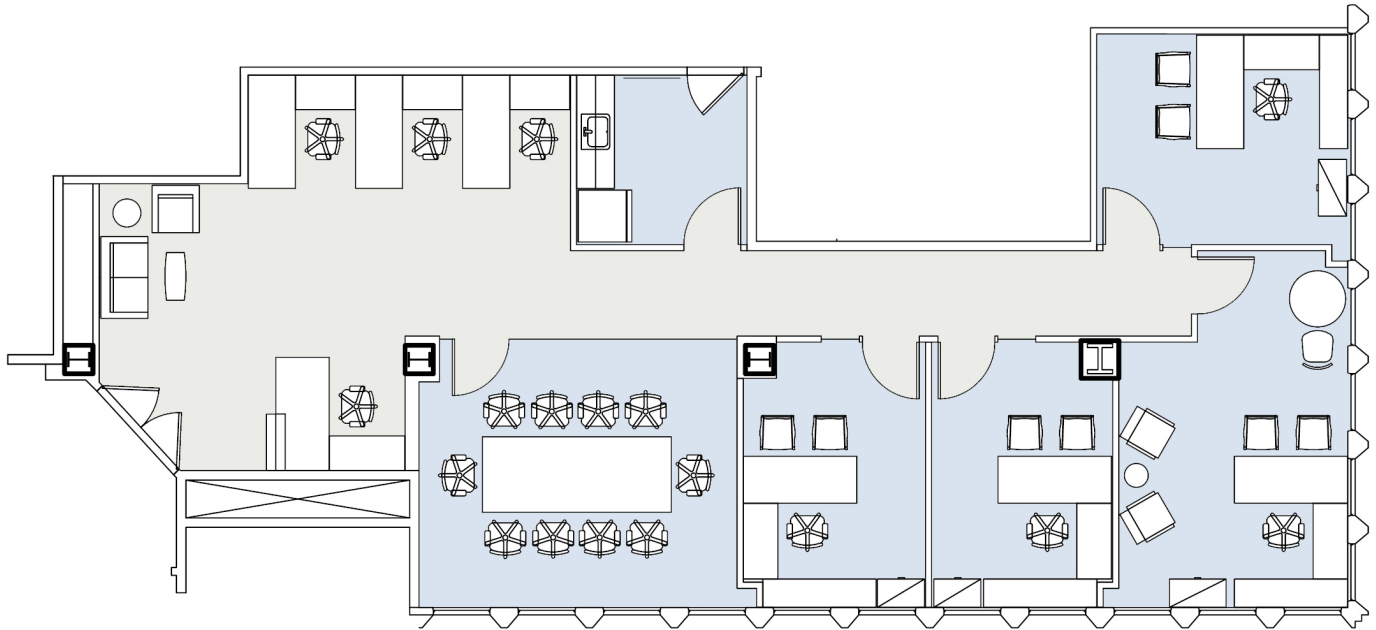

### AS-BUILT CONFIGURATION

OFFICES:	4
RECEPTION:	1
CONFERENCE ROOM:	1
KITCHEN:	1

NOT TO SCALE  
FURNITURE NOT INCLUDED

For more information, please contact:

310.255.7777

leasing@douglasemmett.com

**Douglas  
Emmett**