



# 6300

THE TRILLIUM - WEST TOWER

SUITE 540 | 1,100 RSF

WOODLAND HILLS

## CANOGA AVENUE

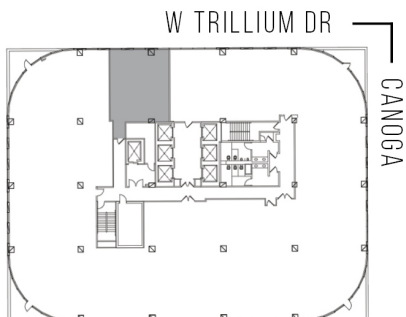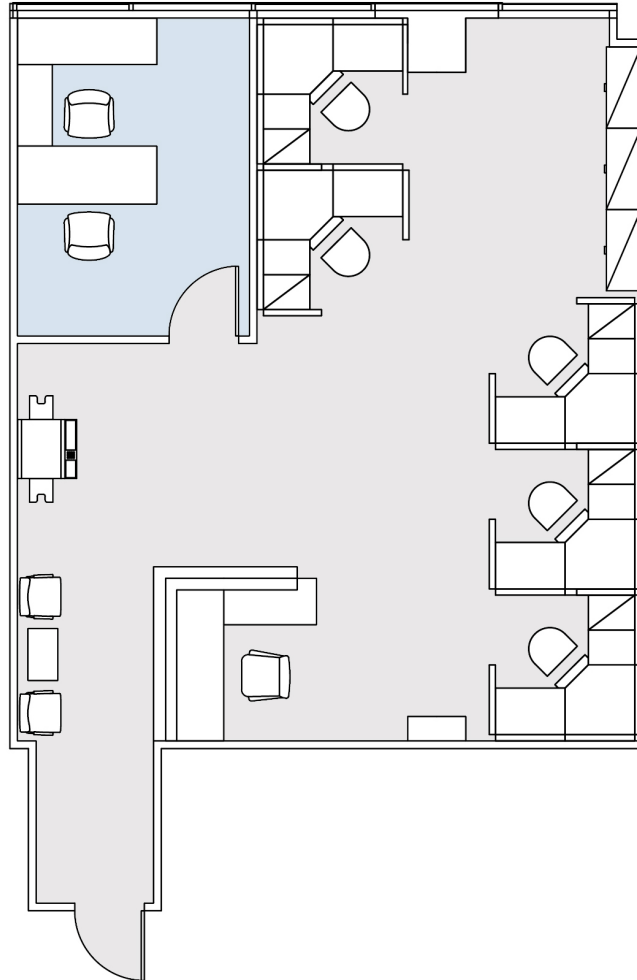

AS-BUILT CONFIGURATION

OFFICES:	1
RECEPTION:	1
OPEN OFFICE:	5

ADJUSTED FOR SOCIAL DISTANCING  
NOT TO SCALE  
FURNITURE NOT INCLUDED

For more information, please contact:

310.255.7777

leasing@douglasemmett.com

**Douglas  
Emmett**