
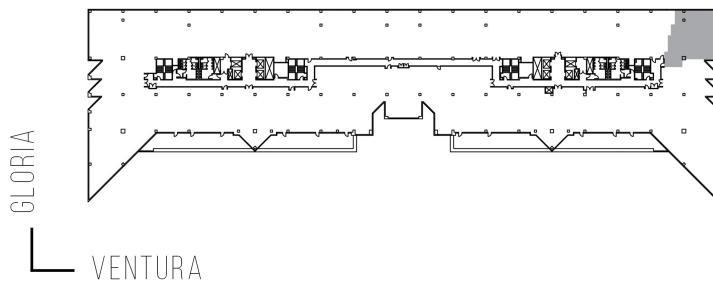


# 15821 VENTURA

ENCINO TERRACE

SUITE 400 | 2,778 RSF

SHERMAN OAKS/ENCINO

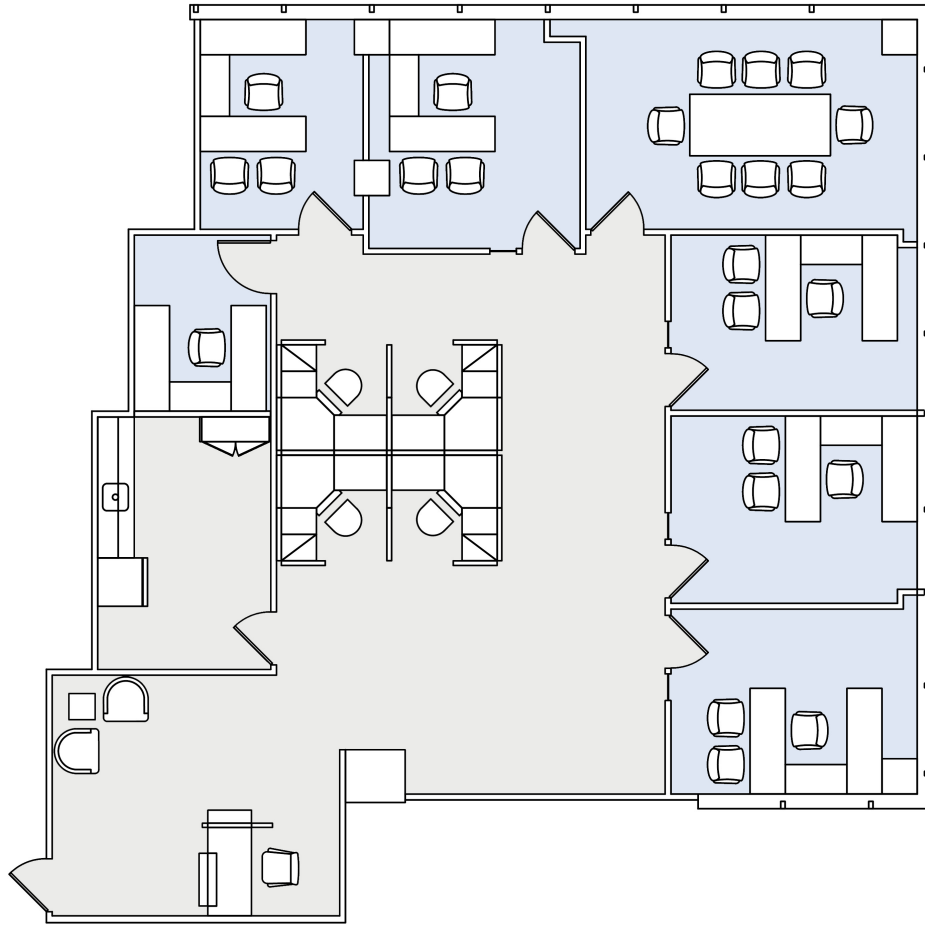

#### AS-BUILT CONFIGURATION

|                  |   |
|------------------|---|
| OFFICES:         | 6 |
| RECEPTION:       | 1 |
| CONFERENCE ROOM: | 1 |
| KITCHEN:         | 1 |

NOT TO SCALE  
FURNITURE NOT INCLUDED

For more information, please contact:

310.255.7777  
leasing@douglasemmett.com

**Douglas  
Emmett**