
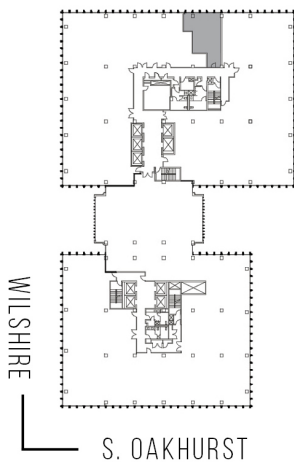


9100 WILSHIRE

9100 WILSHIRE EAST TOWER

SUITE 408 | 806 RSF

BEVERLY HILLS

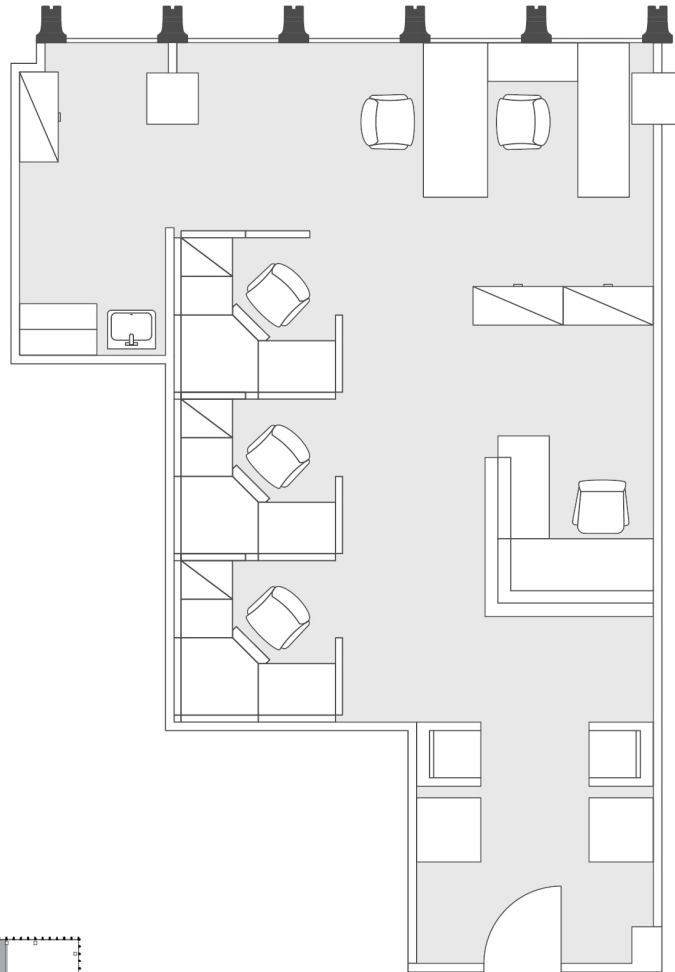

AS-BUILT CONFIGURATION

OFFICES:	1
RECEPTION:	1
OPEN KITCHEN:	1

ADJUSTED FOR SOCIAL DISTANCING
NOT TO SCALE
FURNITURE NOT INCLUDED

For more information, please contact:

310.255.7777

leasing@douglasemmett.com

**Douglas
Emmett**