



6300

THE TRILLIUM - WEST TOWER

SUITE 1150 | 2,657 RSF

WOODLAND HILLS

CANOGA AVENUE

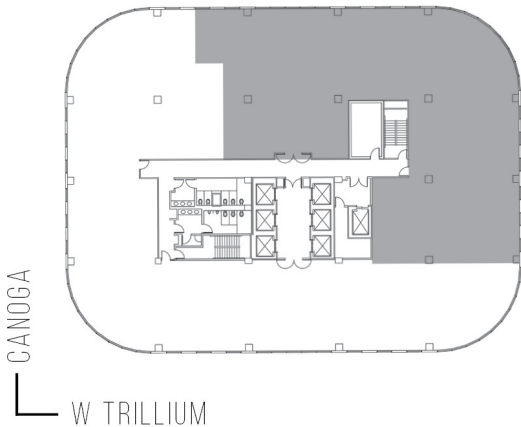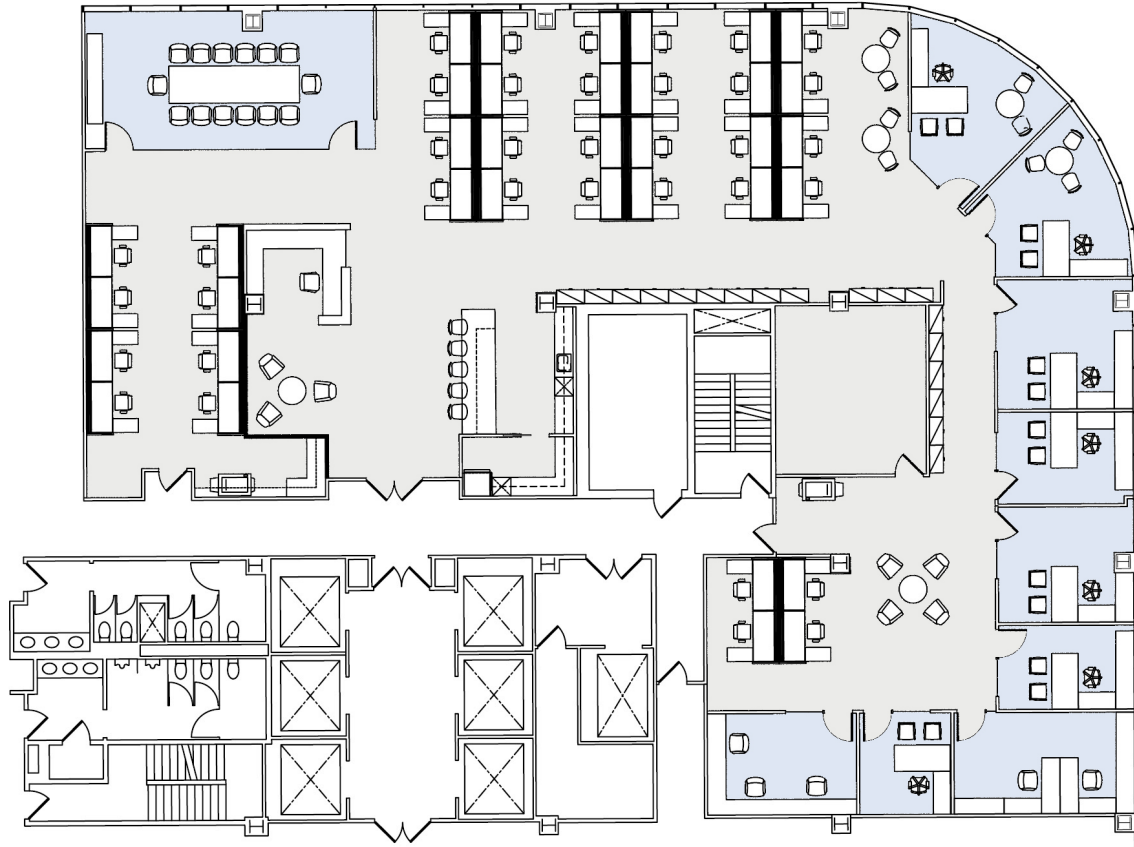

AS-BUILT CONFIGURATION

OFFICES:	9
CONFERENCE ROOM:	1
RECEPTION:	1
SERVER ROOM:	1
KITCHEN:	1

NOT TO SCALE
FURNITURE NOT INCLUDED

For more information, please contact:

310.255.7777

leasing@douglasemmett.com

**Douglas
Emmett**