



6320

THE TRILLIUM - EAST TOWER

SUITE 800 | 18,250 RSF

WOODLAND HILLS

CANOGA AVENUE

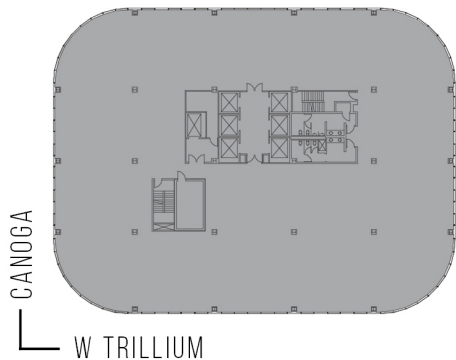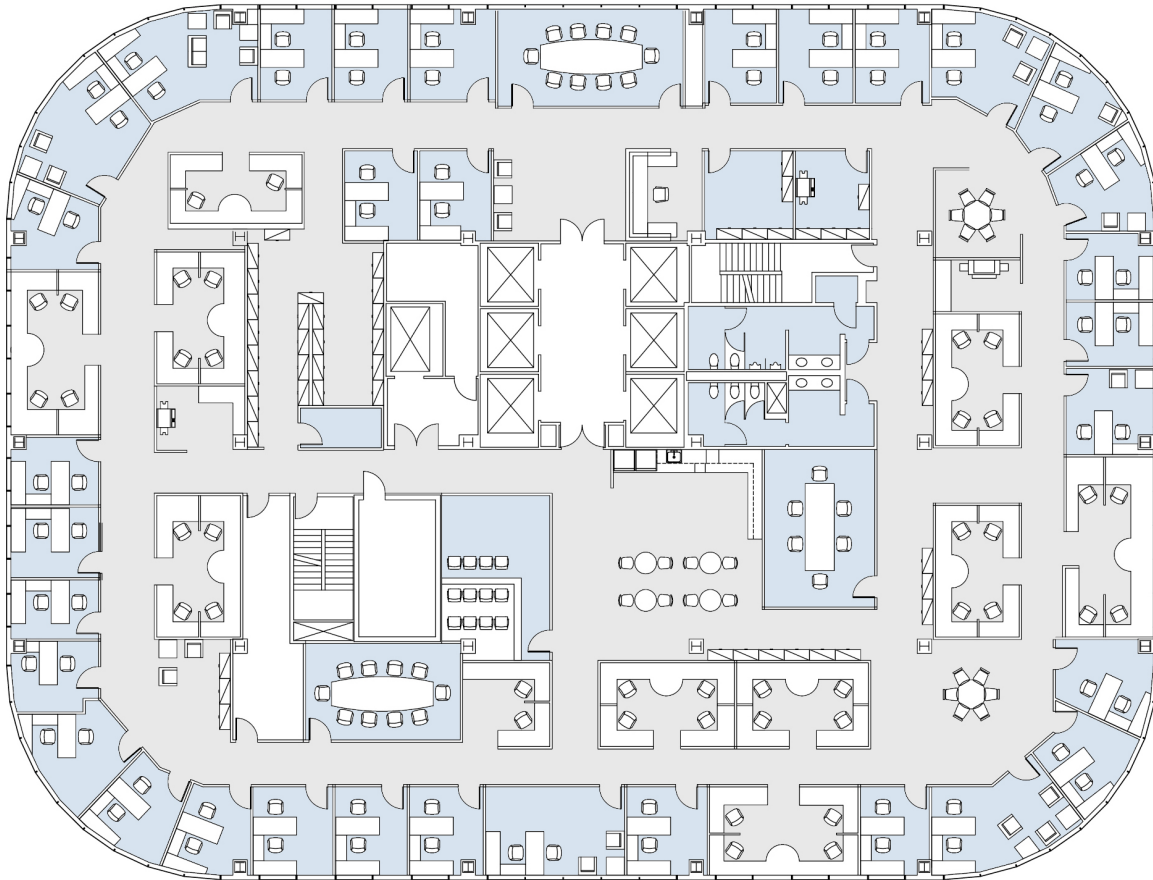

CANOGA

W TRILLIUM

AS-BUILT CONFIGURATION

OFFICES:	31
CONFERENCE ROOMS:	3
RECEPTION:	1
KITCHEN:	1
STORAGE ROOMS:	1
COPY ROOMS:	1
RESTROOMS:	1
THEATER:	1
FILE ROOM:	1

ADJUSTED FOR SOCIAL DISTANCING
NOT TO SCALE
FURNITURE NOT INCLUDED

For more information, please contact:

310.255.7777
leasing@douglasemmett.com

**Douglas
Emmett**