
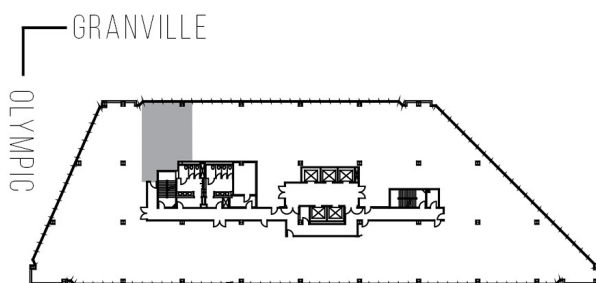


11835 OLYMPIC

WESTSIDE TOWERS EAST TOWER

SUITE 1095 | 1,153 RSF

SAWTELLE/WEST LA

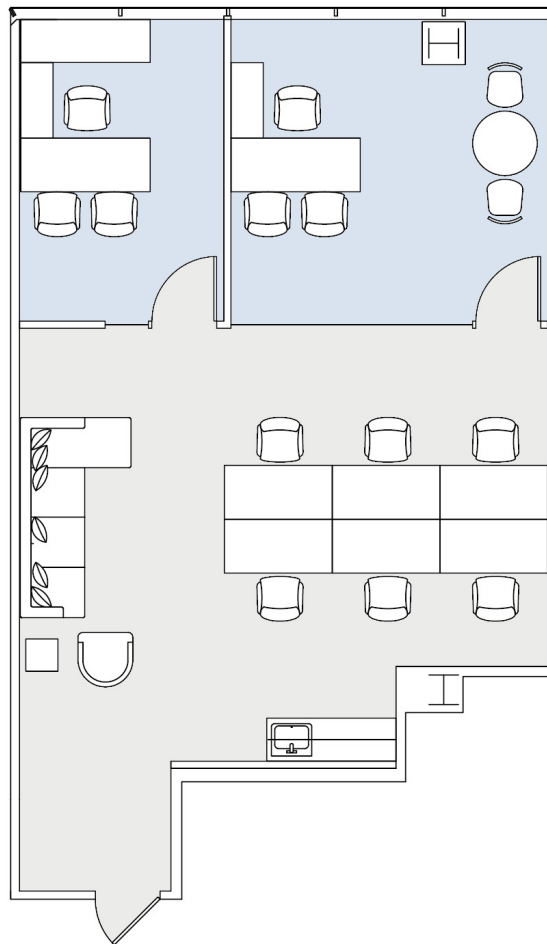

AS-BUILT CONFIGURATION

OFFICES:	2
OPEN KITCHENETTE:	1
RECEPTION AREA:	1

NOT TO SCALE
FURNITURE NOT INCLUDED

For more information, please contact:

310.255.7777

leasing@douglasemmett.com

**Douglas
Emmett**