
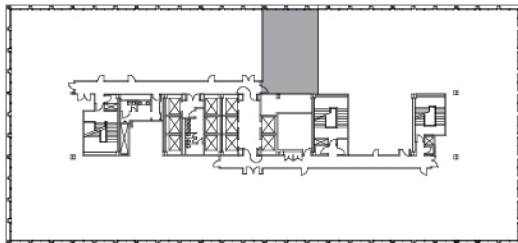


1901 AVENUE OF THE STARS

SUITE 900 | 13,454 RSF
CENTURY CITY

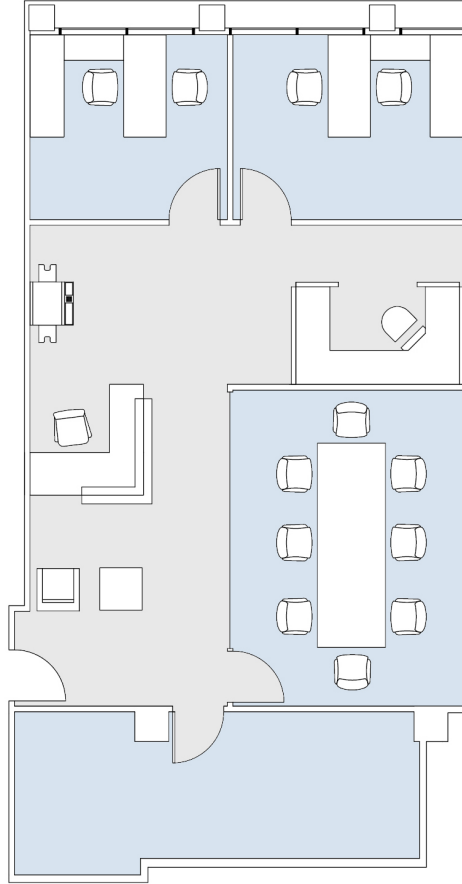

— AVENUE OF THE STARS —

AS-BUILT CONFIGURATION

OFFICES:	2
CONFERENCE ROOM:	1
RECEPTION:	1
STORAGE/SERVER ROOM:	1

ADJUSTED FOR SOCIAL DISTANCING
NOT TO SCALE
FURNITURE NOT INCLUDED

For more information, please contact:

310.255.7777
leasing@douglasemmett.com

**Douglas
Emmett**