
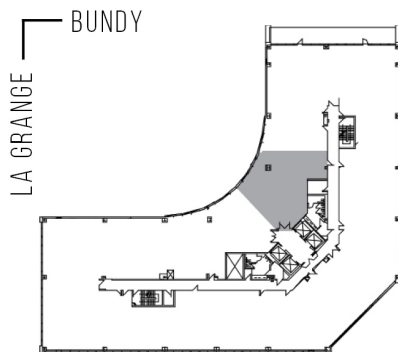


1990 SOUTH BUNDY

CORNERSTONE PLAZA

SUITE 300 | 2,007 RSF

SAWTELLE/WEST LA

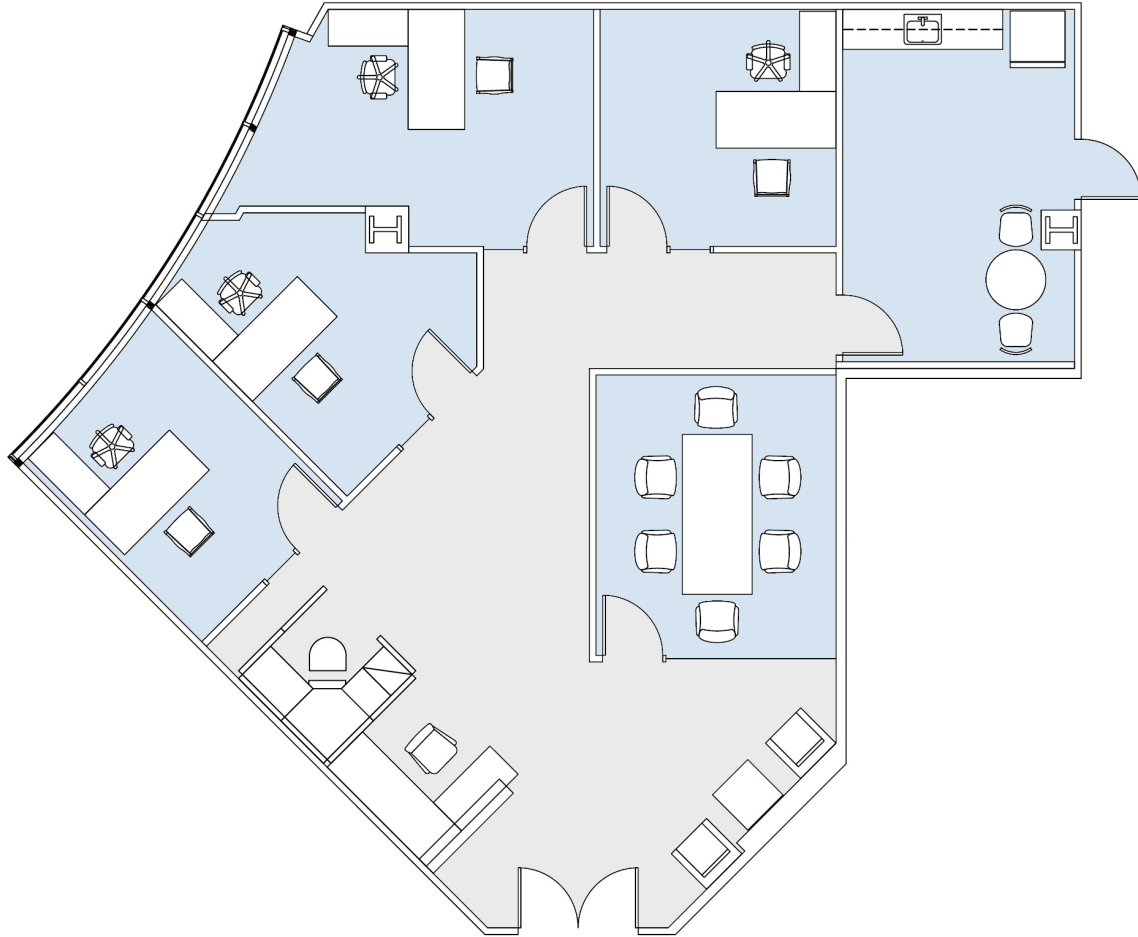

AS-BUILT CONFIGURATION

OFFICE:	4
CONFERENCE ROOM:	1
RECEPTION:	1
KITCHEN:	1

ADJUSTED FOR SOCIAL DISTANCING
NOT TO SCALE
FURNITURE NOT INCLUDED

For more information, please contact:

310.255.7777

leasing@douglasemmett.com

**Douglas
Emmett**