
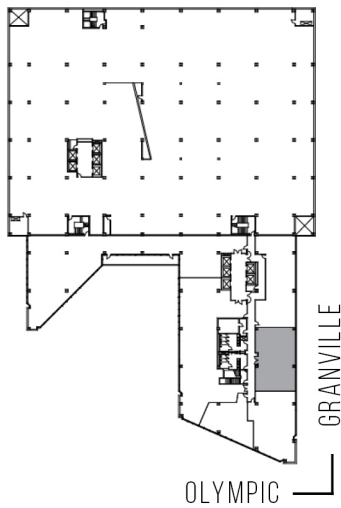


11835 OLYMPIC

WESTSIDE TOWERS EAST TOWER

SUITE 375 | 2,010 RSF

SAWTELLE/WEST LA

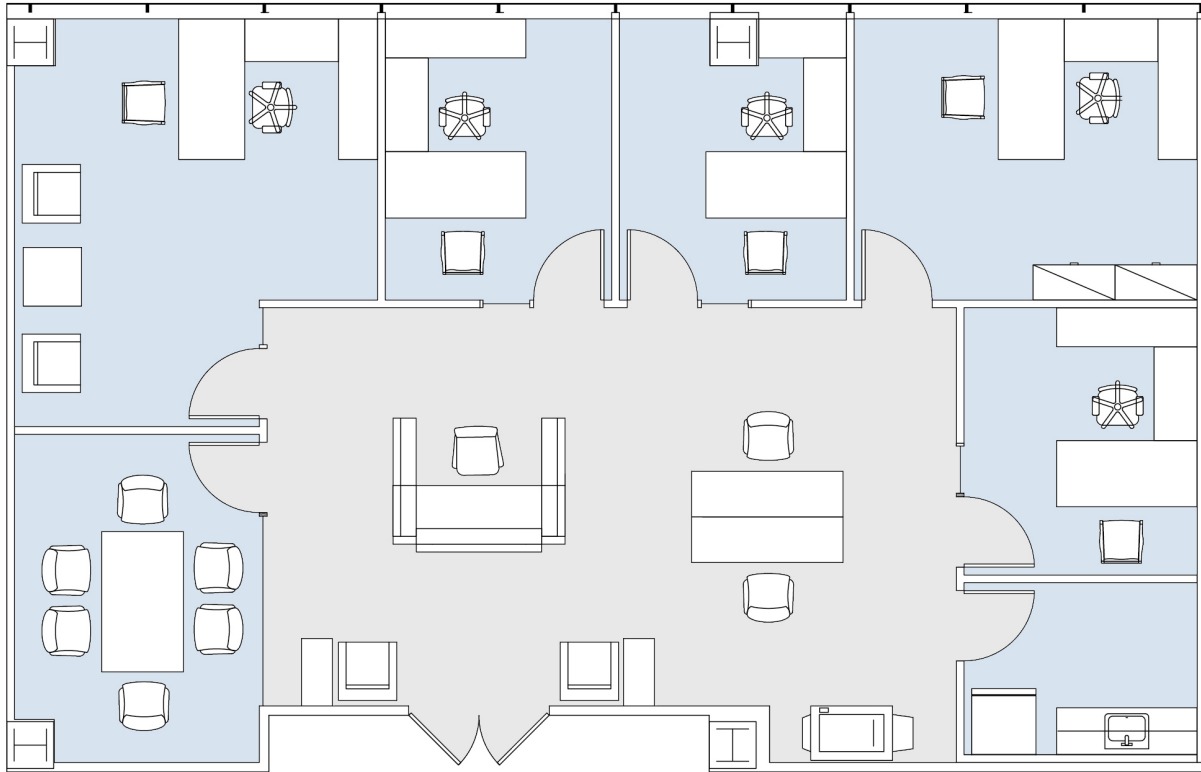

AS-BUILT CONFIGURATION

OFFICES:	5
CONFERENCE ROOM:	1
KITCHEN:	1
RECEPTION:	1

ADJUSTED FOR SOCIAL DISTANCING
NOT TO SCALE
FURNITURE NOT INCLUDED

For more information, please contact:

310.255.7777
leasing@douglasemmett.com

**Douglas
Emmett**