
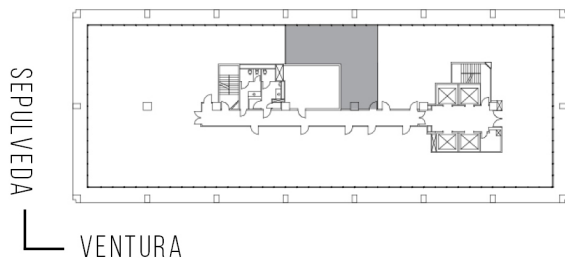


15233 VENTURA

VALLEY OFFICE PLAZA

SUITE 1216 | 995 RSF

SHERMAN OAKS/ENCINO

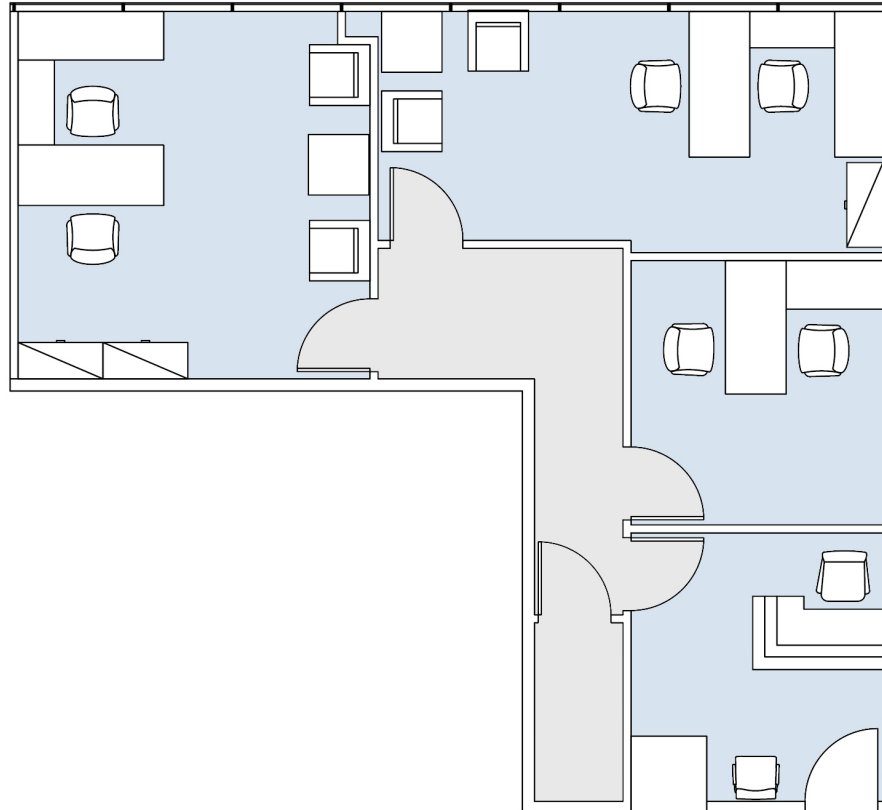

AS-BUILT CONFIGURATION

OFFICES:	3
RECEPTION AREA:	1
STORAGE CLOSET:	1

ADJUSTED FOR SOCIAL DISTANCING
NOT TO SCALE
FURNITURE NOT INCLUDED

For more information, please contact:

310.255.7777

leasing@douglasemmett.com

**Douglas
Emmett**