
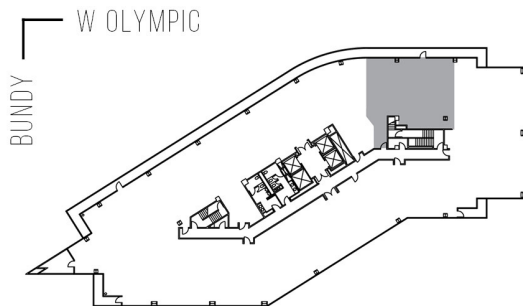


11900 OLYMPIC

BUNDY/OLYMPIC

SUITE 810 | 1,951 RSF

SAWTELLE/WEST LA

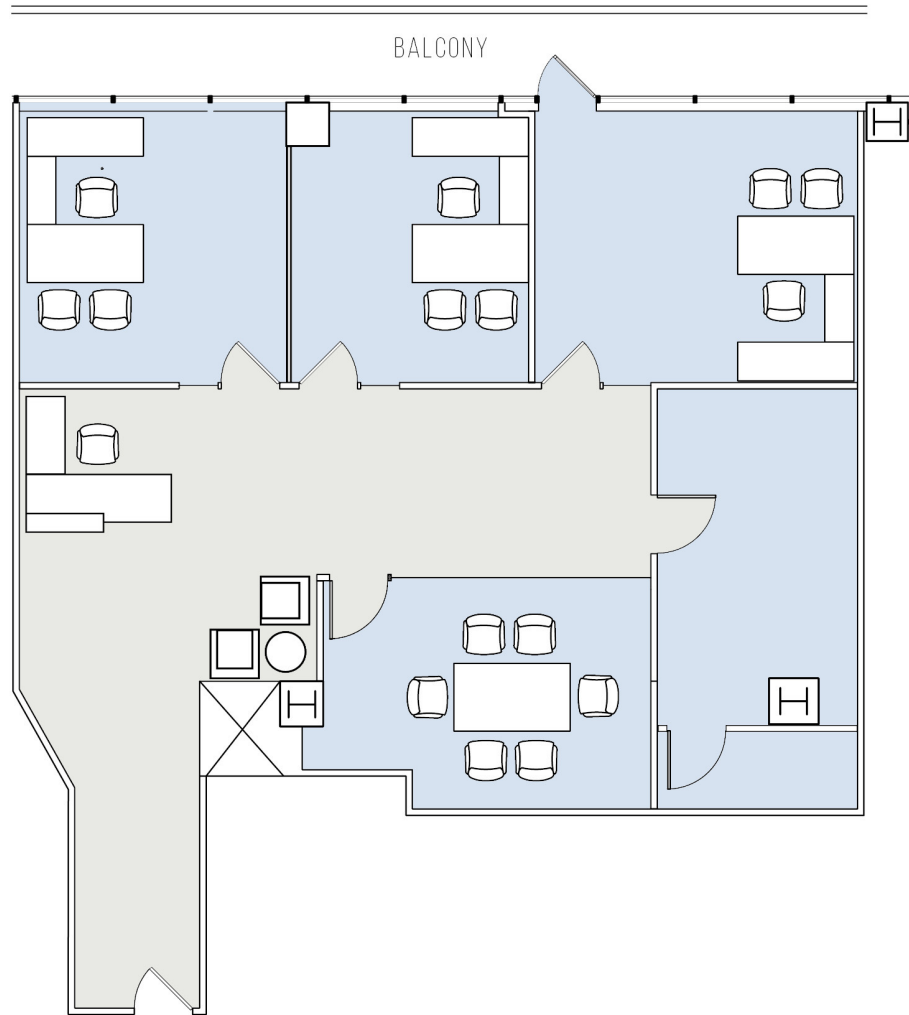

AS-BUILT CONFIGURATION

OFFICES:	3
RECEPTION:	1
CONFERENCE ROOM:	1
STORAGE ROOM:	1
SERVER ROOM:	1

NOT TO SCALE

For more information, please contact:

310.255.7777

leasing@douglasemmett.com

**Douglas
Emmett**