
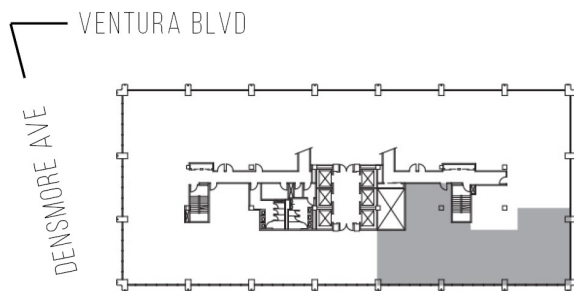


# 15760 VENTURA

ENCINO GATEWAY

SUITE 1440 | 3,636 RSF

SHERMAN OAKS/ENCINO

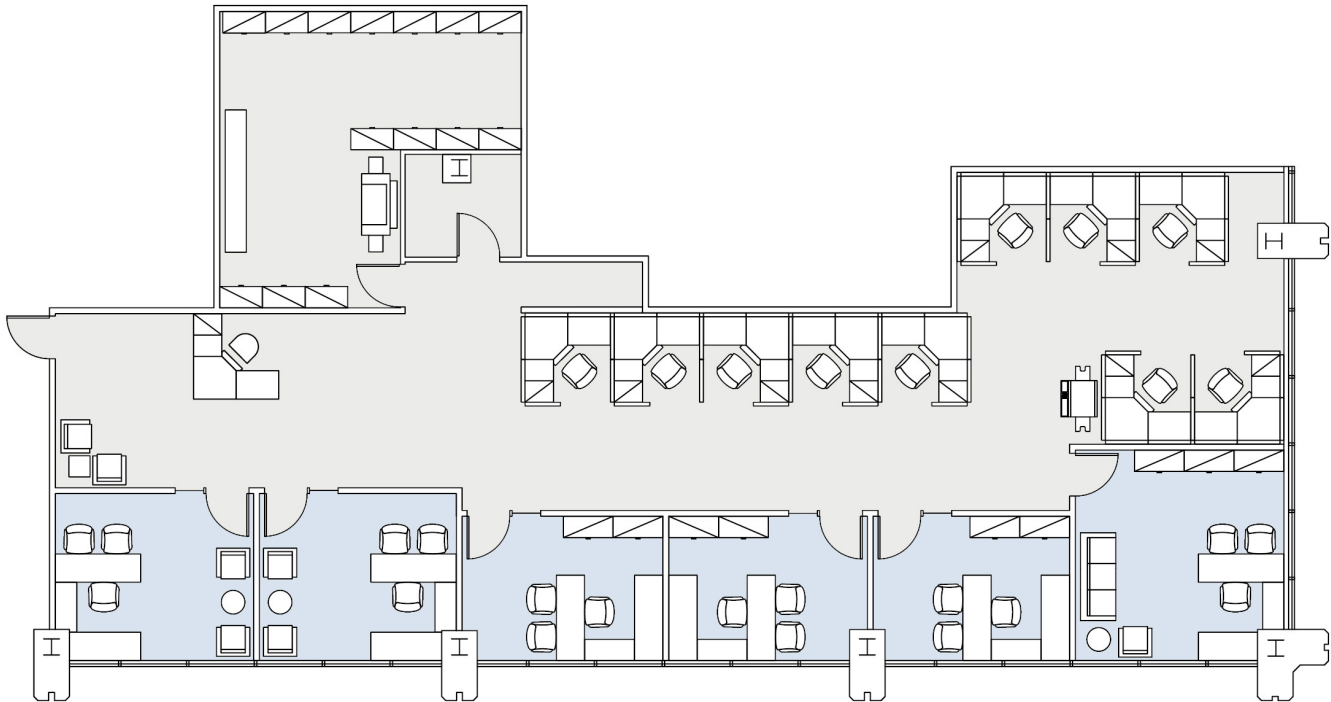

#### AS-BUILT CONFIGURATION

OFFICES:	6
RECEPTION:	1
STORAGE ROOM:	1
FILE ROOM:	1

NOT TO SCALE  
FURNITURE NOT INCLUDED

For more information, please contact:

310.255.7777

leasing@douglasemmett.com

**Douglas  
Emmett**