
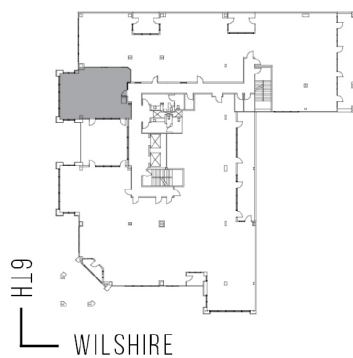


530 WILSHIRE

VERONA

SUITE 200 | 1,099 RSF

SANTA MONICA

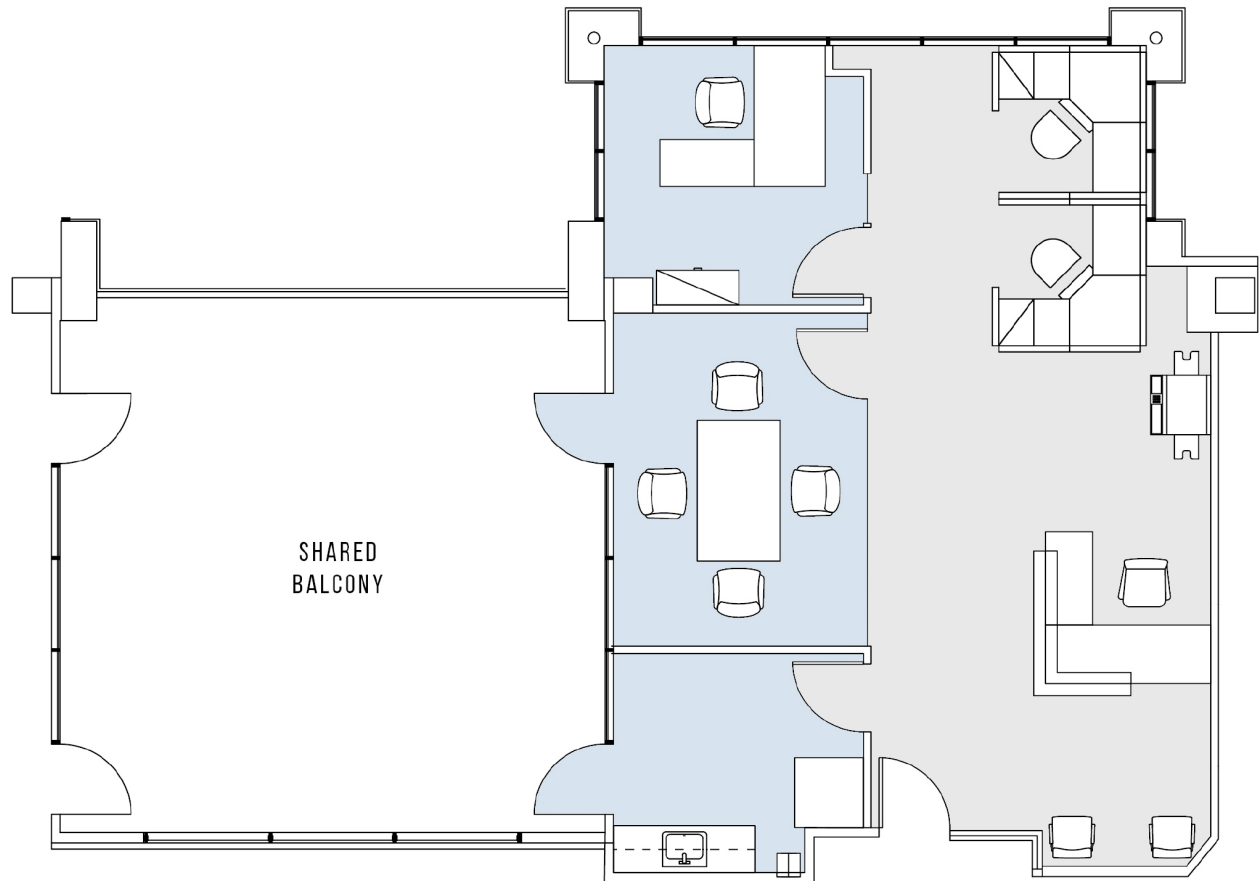

AS-BUILT CONFIGURATION

| | |
|------------------|---|
| OFFICES: | 1 |
| CONFERENCE ROOM: | 1 |
| KITCHEN: | 1 |
| RECEPTION AREA: | 1 |
| SHARED BALCONY: | 1 |

ADJUSTED FOR SOCIAL DISTANCING
NOT TO SCALE
FURNITURE NOT INCLUDED

For more information, please contact:

310.255.7777

leasing@douglasemmett.com

**Douglas
Emmett**