
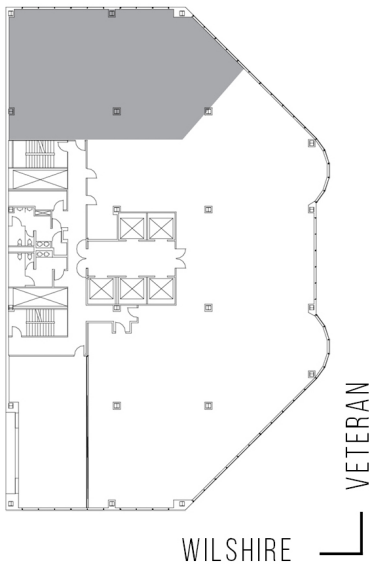


10990 WILSHIRE

ONE WESTWOOD

SUITE 440 | 3,117 RSF

WESTWOOD

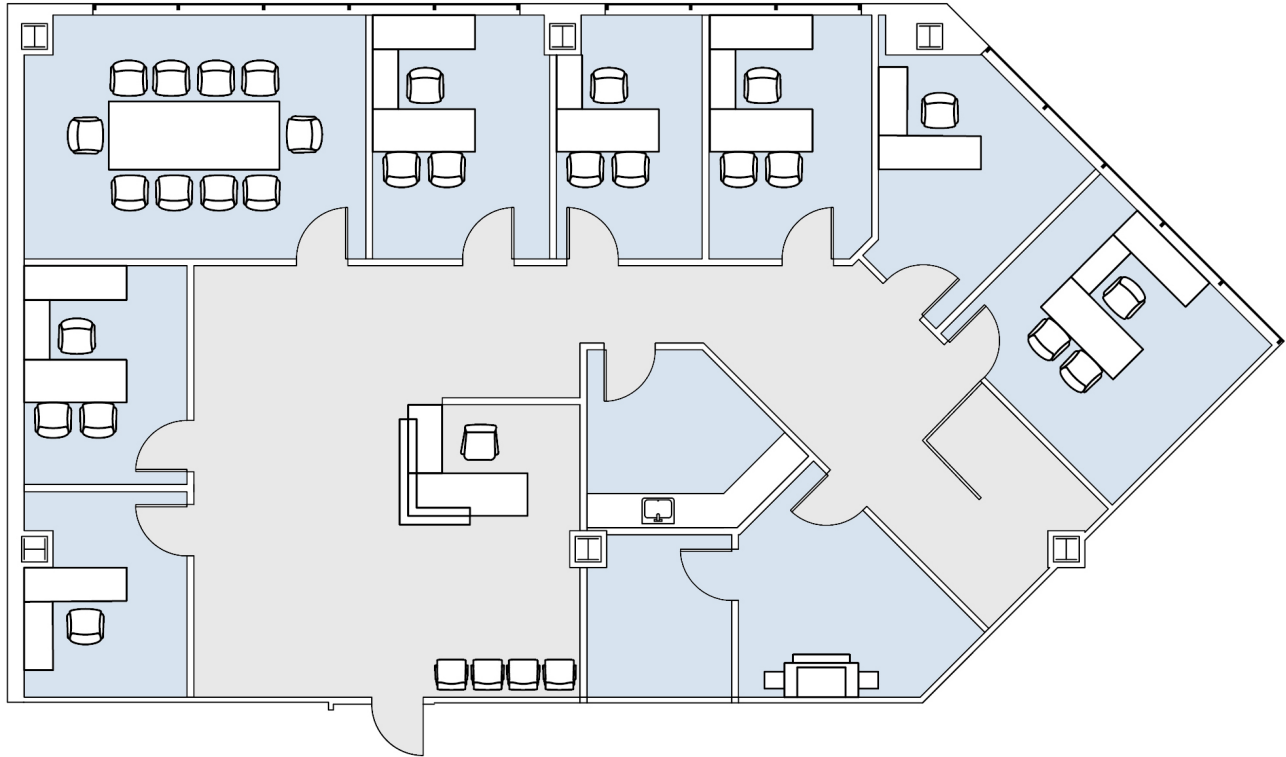

AS-BUILT CONFIGURATION

OFFICES:	7
CONFERENCE ROOM:	1
SERVER ROOM:	1
COPY ROOM:	1
KITCHEN:	1

NOT TO SCALE
FURNITURE NOT INCLUDED

For more information, please contact:

310.255.7777

leasing@douglasemmett.com

**Douglas
Emmett**