



21550

OXNARD STREET

WARNER CENTER TOWER - II

SUITE 480 | 1,001 RSF

WOODLAND HILLS

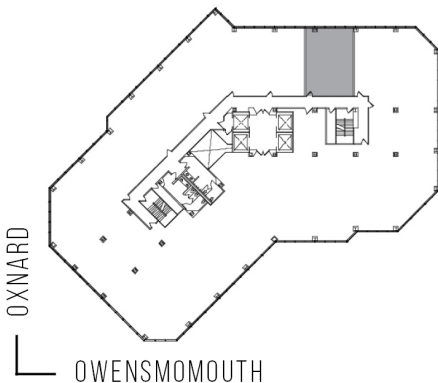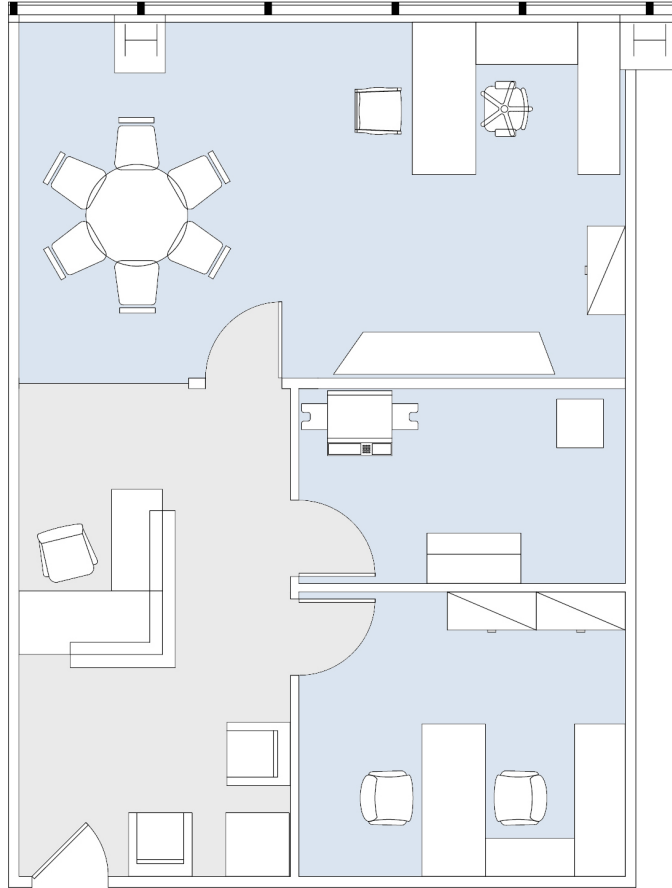

AS-BUILT CONFIGURATION

OFFICES:	2
RECEPTION:	1
I.T. ROOM:	1

ADJUSTED FOR SOCIAL DISTANCING
NOT TO SCALE
FURNITURE NOT INCLUDED

For more information, please contact:

310.255.7777
leasing@douglasemmett.com

**Douglas
Emmett**