
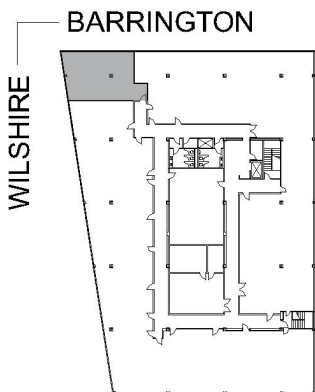


# 11704 BARRINGTON PLAZA - COMMERCIAL SUITE 250 | 869 RSF

## WILSHIRE BRENTWOOD-WILSHIRE

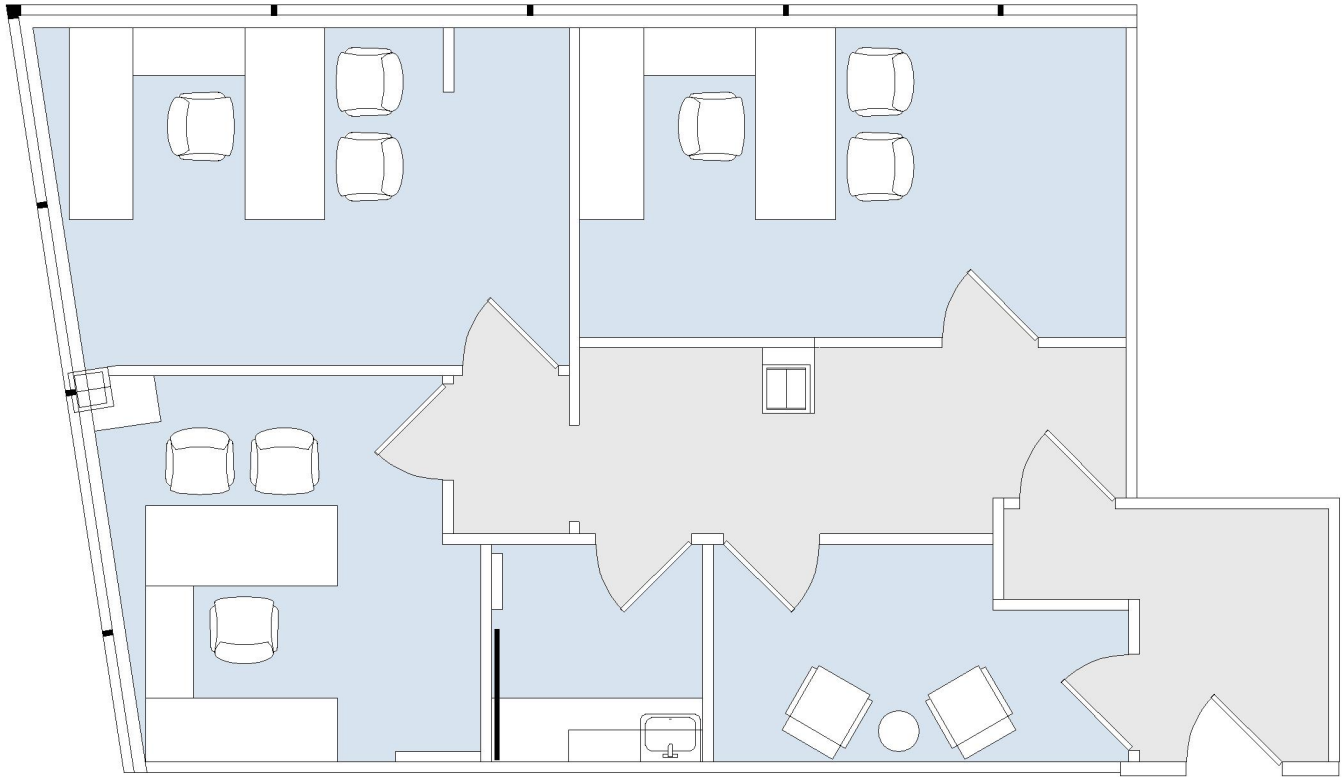

### AS-BUILT CONFIGURATION

OFFICES:	3
WAITING ROOM:	1
KITCHEN:	1

NOT TO SCALE  
FURNITURE NOT INCLUDED

For more information, please contact:

310.255.7777  
leasing@douglasemmett.com

**Douglas  
Emmett**