
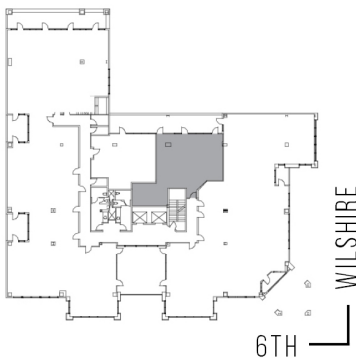


530 WILSHIRE

VERONA

SUITE 207 | 1,272 RSF

SANTA MONICA

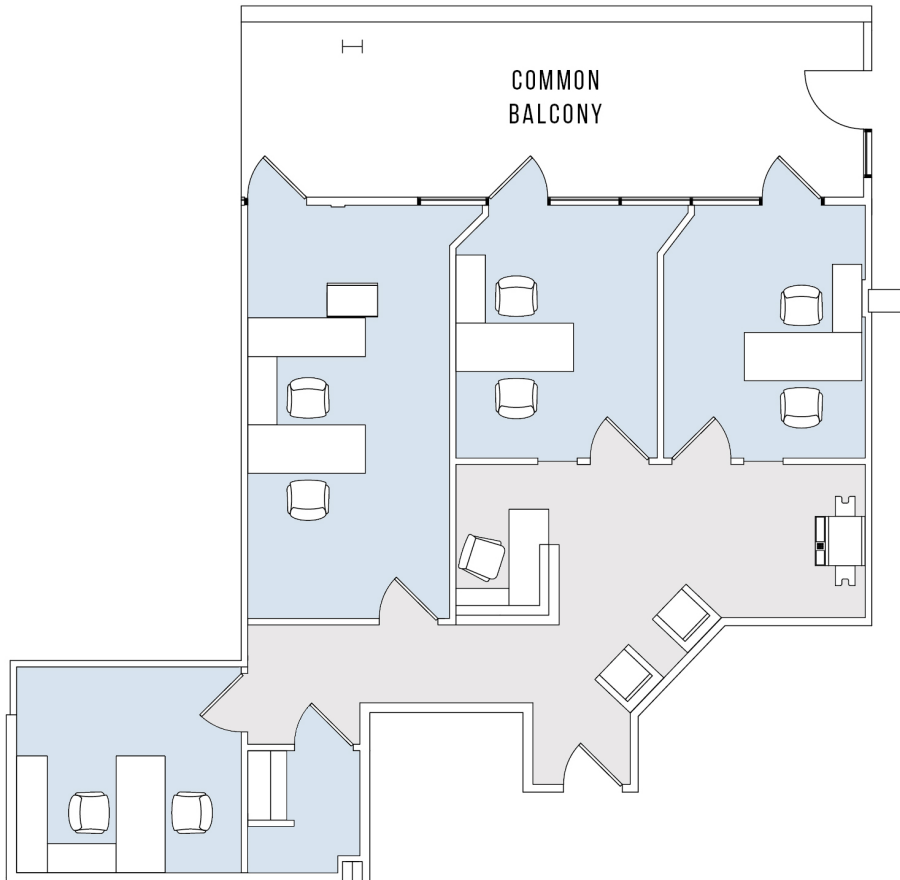

AS-BUILT CONFIGURATION

OFFICES:	4
RECEPTION AREA:	1
I.T. ROOM:	1

ADJUSTED FOR SOCIAL DISTANCING
NOT TO SCALE
FURNITURE NOT INCLUDED

For more information, please contact:

310.255.7777
leasing@douglasemmett.com

**Douglas
Emmett**