
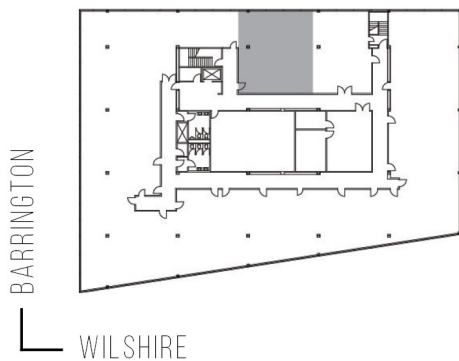


# 11704 BARRINGTON PLAZA - COMMERCIAL SUITE 202 | 1,381 RSF

## WILSHIRE BRENTWOOD-WILSHIRE

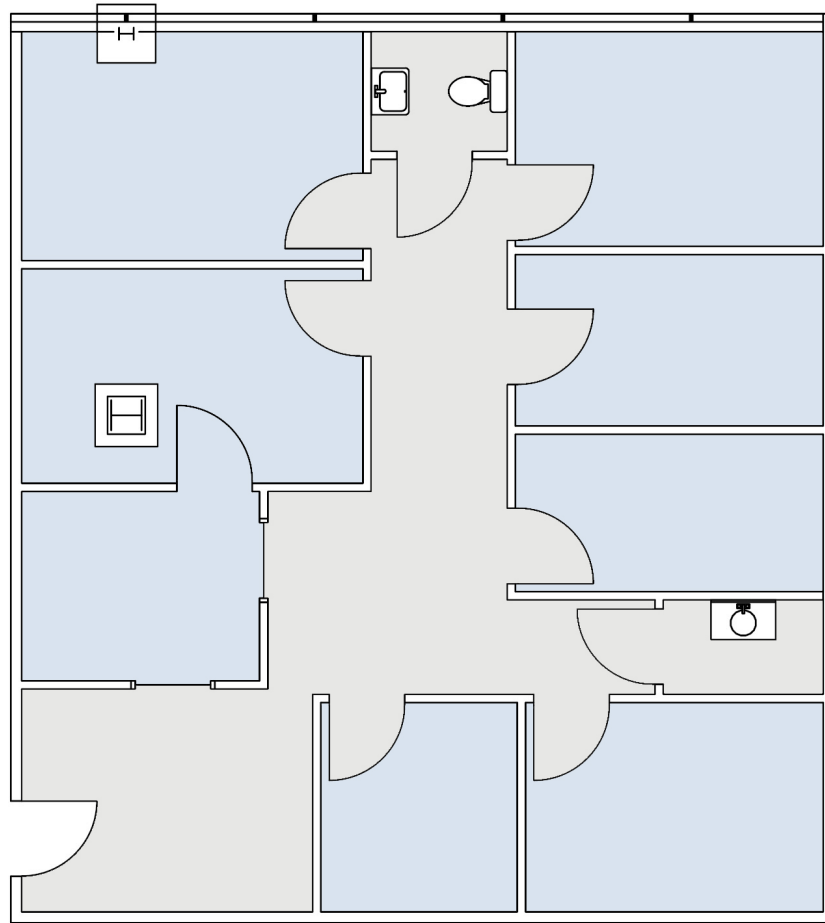

### AS BUILT CONFIGURATION

TREATMENT ROOMS:	6
OFFICE:	2
RECEPTION	1
KITCHEN:	1
RESTEROOM:	1

NOT TO SCALE  
FURNITURE NOT INCLUDED

For more information, please contact:

310.255.7777  
leasing@douglasemmett.com

**Douglas  
Emmett**