
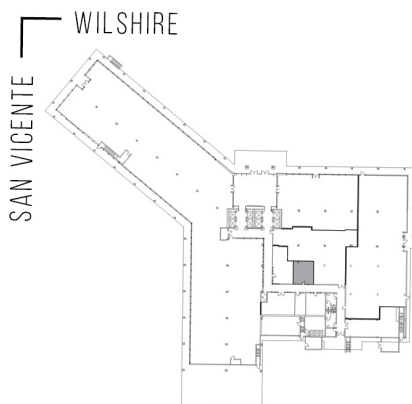


8383

WILSHIRE

SUITE 114 | 520 RSF

BEVERLY HILLS

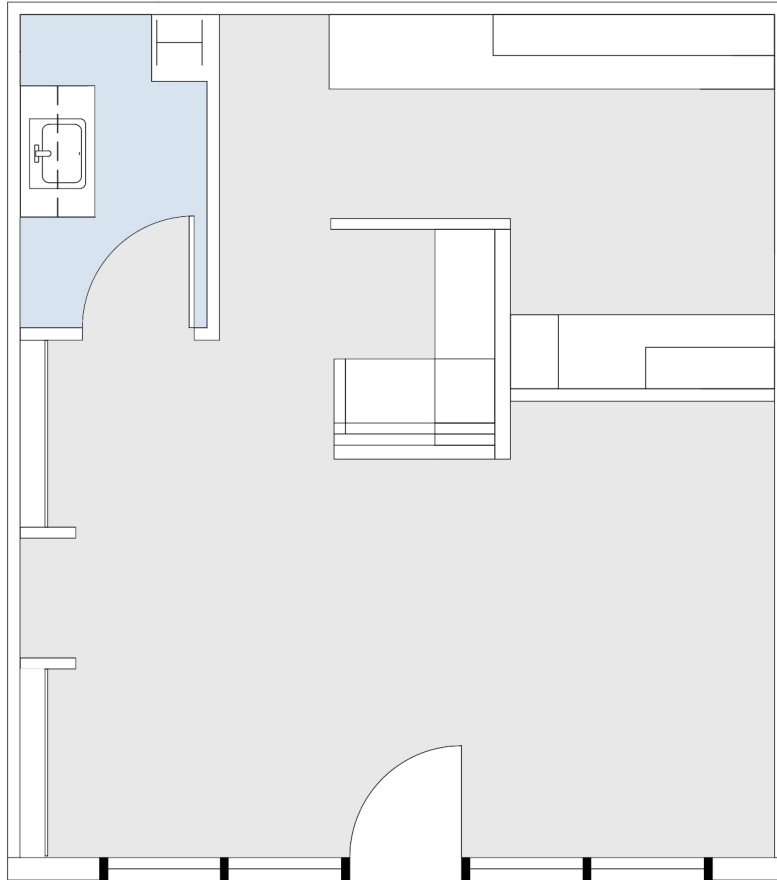

AS-BUILT CONFIGURATION

NOT TO SCALE
FURNITURE NOT INCLUDED

For more information, please contact:

310.255.7777
leasing@douglasemmett.com

**Douglas
Emmett**