
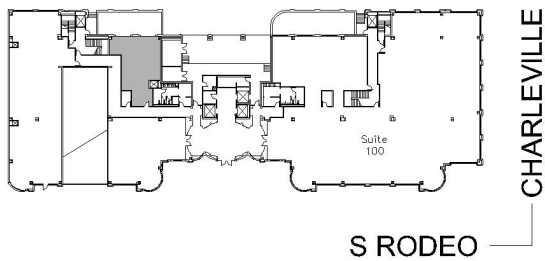


150 S RODEO DRIVE

SUITE 130 | 1,193 RSF
BEVERLY HILLS

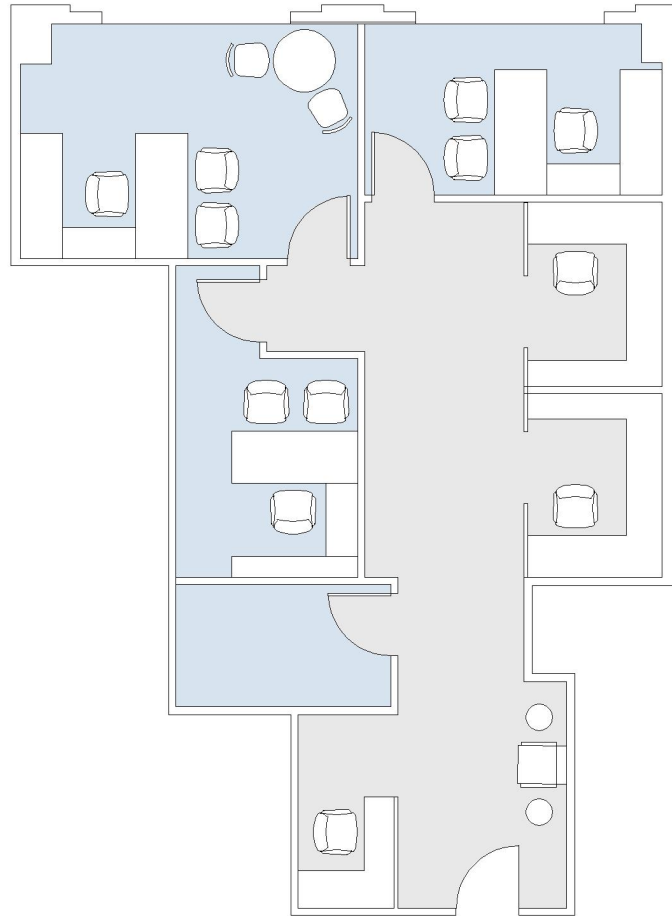

AS-BUILT CONFIGURATION

OFFICES:	3
RECEPTION:	1
STORAGE:	1

NOT TO SCALE
FURNITURE NOT INCLUDED

For more information, please contact:

310.255.7777
leasing@douglasemmett.com

**Douglas
Emmett**