



# 6310

CARTHAY CAMPUS 10

SUITE 510 | 2,794 RSF

BEVERLY HILLS

## SAN VICENTE

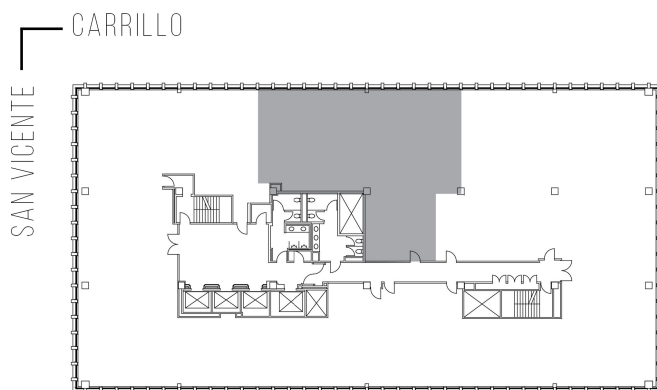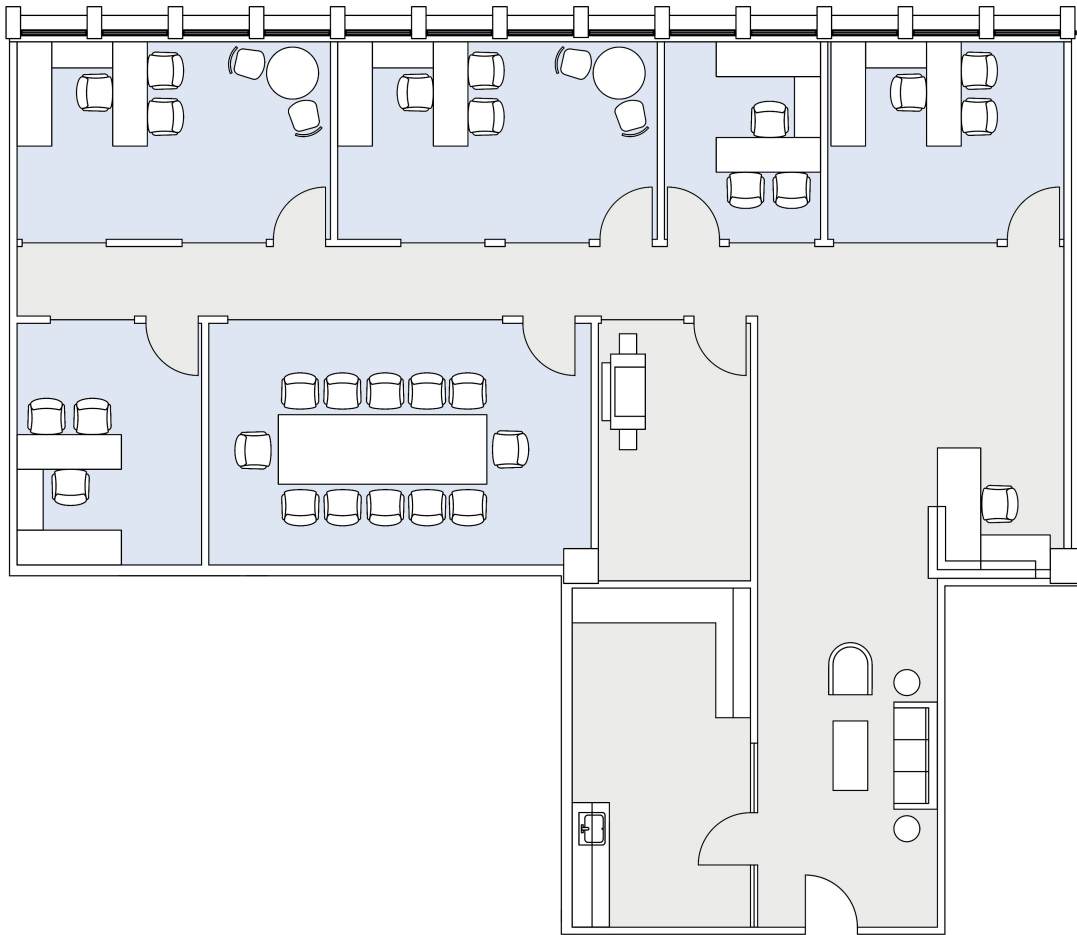

### AS-BUILT CONFIGURATION

OFFICES:	5
CONFERENCE ROOM:	1
RECEPTION:	1
KITCHEN:	1
FILE/COPY ROOM:	1

NOT TO SCALE  
FURNITURE NOT INCLUDED

For more information, please contact:

CARLTON MAESE  
310.255.7781

MELINDA MECHOSO  
310.255.7737

EDMUND HA  
310.255.7743

cmaese@douglasemmett.com mmechoso@douglasemmett.com edmund.ha@douglasemmett.com

**Douglas  
Emmett**