
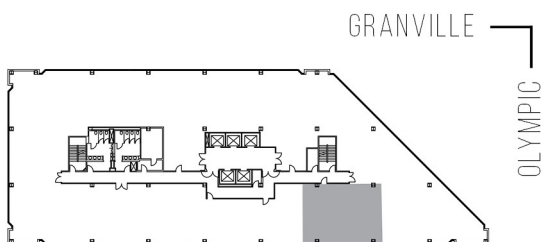


11845 OLYMPIC

WESTSIDE TOWERS WEST TOWER

SUITE 775 | 1,660 RSF

SAWTELLE/WEST LA

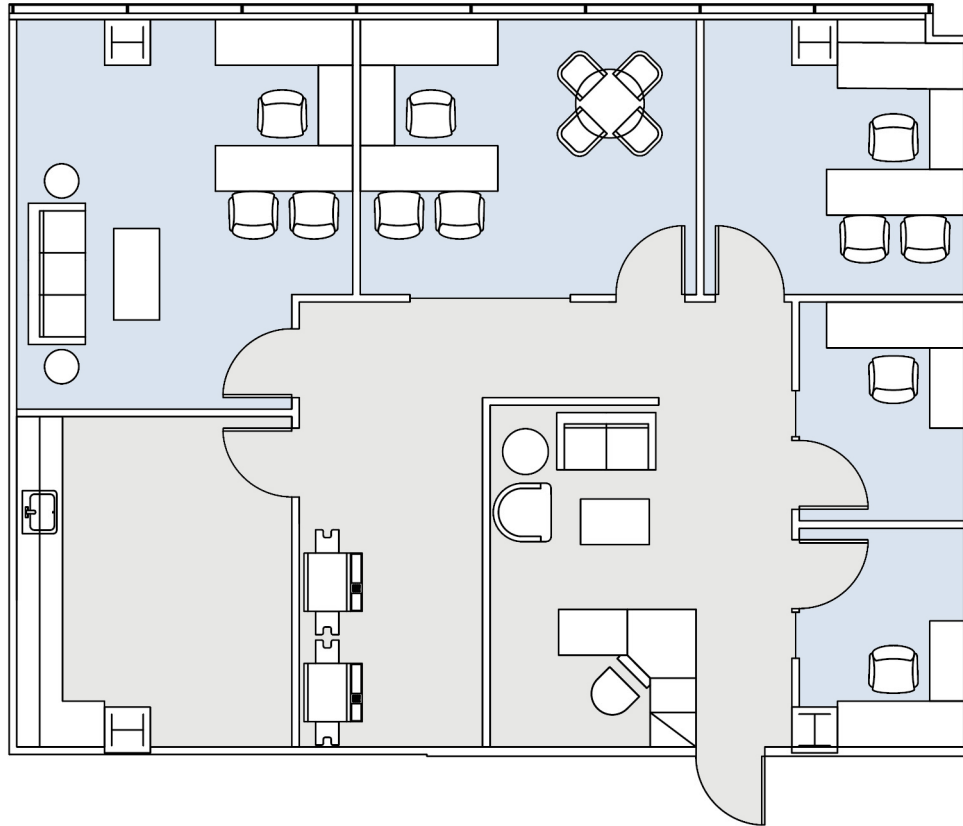

AS-BUILT CONFIGURATION

OFFICES:	5
RECEPTION:	1
KITCHEN:	1

NOT TO SCALE
FURNITURE NOT INCLUDED

For more information, please contact:

310.255.7777
leasing@douglasemmett.com

**Douglas
Emmett**