


11835 OLYMPIC

WESTSIDE TOWERS EAST TOWER

SUITE 440 | 2,201 RSF

SAWTELLE/WEST LA

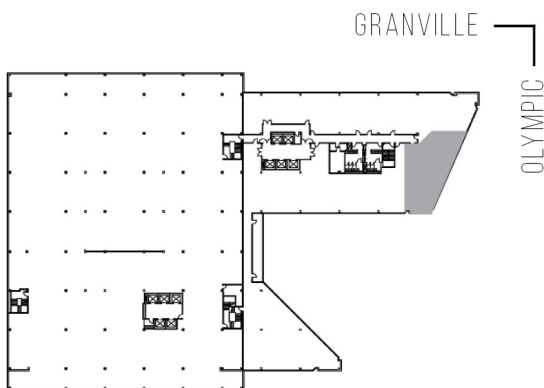

AS-BUILT CONFIGURATION

WINDOW OFFICES:	4
CONFERENCE ROOM:	1
KITCHEN:	1
RECEPTION AREA:	1

NOT TO SCALE

For more information, please contact:

310.255.7777

leasing@douglasemmett.com

**Douglas
Emmett**