


11900 OLYMPIC

BUNDY/OLYMPIC

SUITE 800 | 18,064 RSF

SAWTELLE/WEST LA

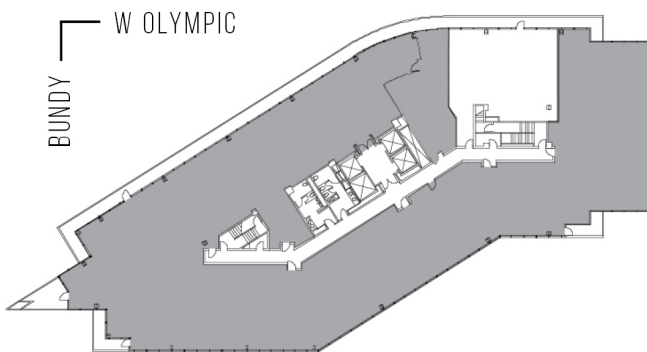

AS-BUILT CONFIGURATION

OFFICES:	41
CONFERENCE ROOMS:	4
RECEPTION:	1
KITCHEN:	1
COPY ROOM:	1
I.T. ROOM:	1
FILE ROOM:	1
BALCONIES:	4

ADJUSTED FOR SOCIAL DISTANCING

NOT TO SCALE
FURNITURE NOT INCLUDED

For more information, please contact:

310.255.7777

leasing@douglasemmett.com

**Douglas
Emmett**