
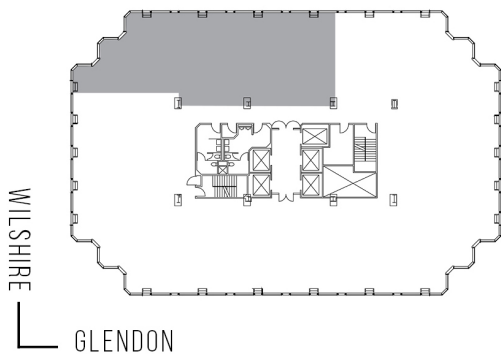


10866  
WILSHIRE

WESTWOOD PLACE

SUITE 250 | 3,096 RSF

WESTWOOD

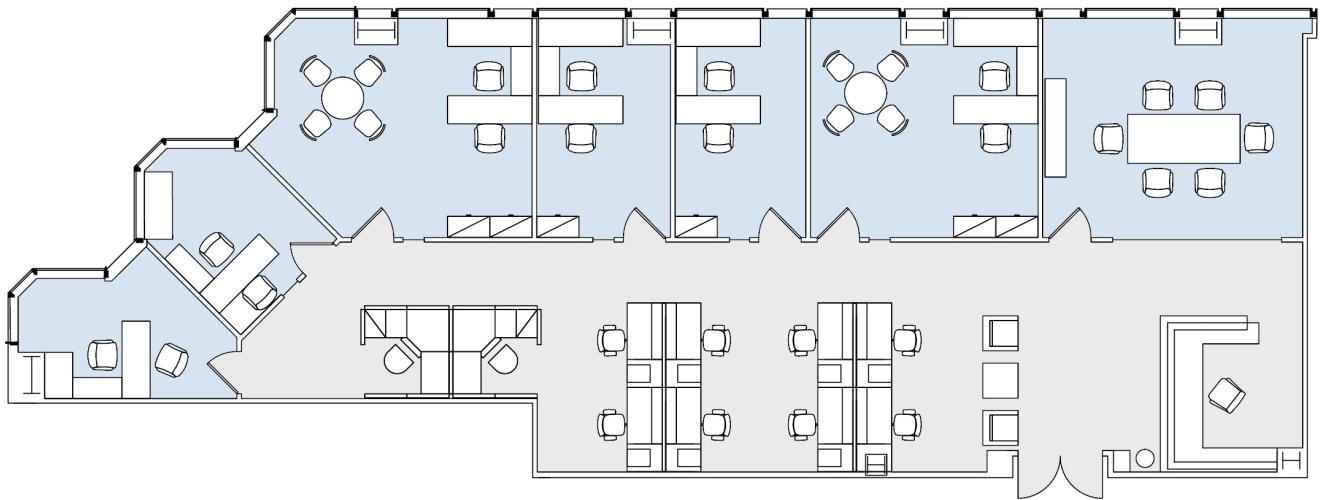

AS-BUILT CONFIGURATION

OFFICES:	6
CONFERENCE ROOM:	1
RECEPTION:	1

ADJUSTED FOR SOCIAL DISTANCING  
NOT TO SCALE  
FURNITURE NOT INCLUDED

For more information, please contact:

310.255.7777  
leasing@douglasemmett.com

**Douglas  
Emmett**