

## SHERMAN OAKS/ENCINO

## **VENTURA**

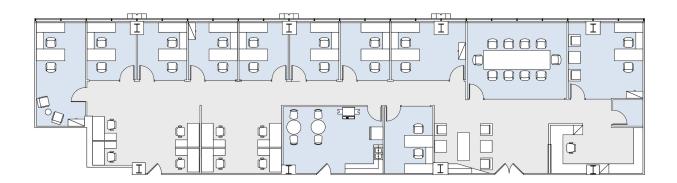

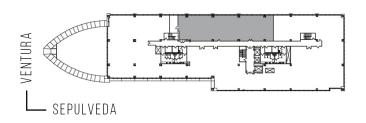

## AS-BUILT CONFIGURATION

OFFICES:	10
CONFERENCE ROOM:	1
RECEPTION:	1
KITCHEN:	1
IT ROOM:	1

ADJUSTED FOR SOCIAL DISTANCING NOT TO SCALE FURNITURE NOT INCLUDED

For more information, please contact:

