



530

VERONA

SUITE 202 | 2,064 RSF

SANTA MONICA

WILSHIRE

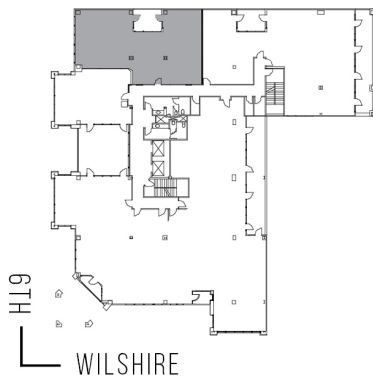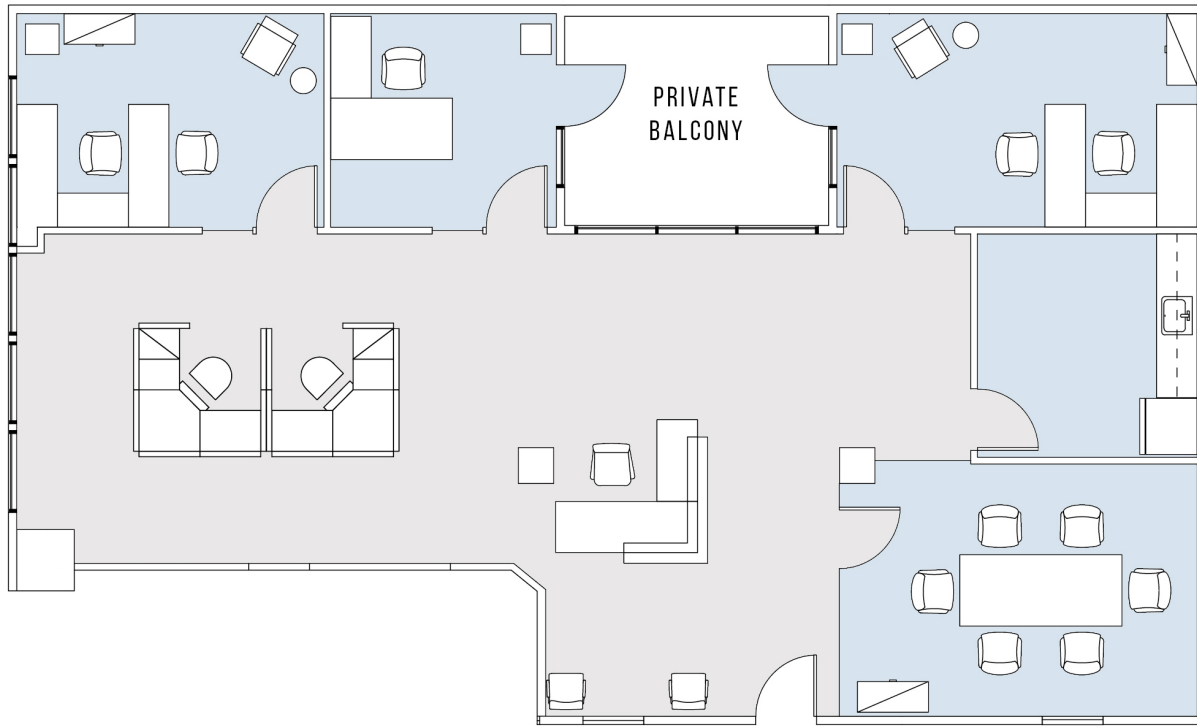

AS-BUILT CONFIGURATION

OFFICES:	3
CONFERENCE ROOM:	1
KITCHEN:	1
RECEPTION AREA:	1
PRIVATE BALCONY:	1

ADJUSTED FOR SOCIAL DISTANCING
NOT TO SCALE
FURNITURE NOT INCLUDED

For more information, please contact:

310.255.7777
leasing@douglasemmett.com

**Douglas
Emmett**