



21600

WARNER CENTER TOWER - I

SUITE 870 | 3,223 RSF

WOODLAND HILLS

OXNARD STREET

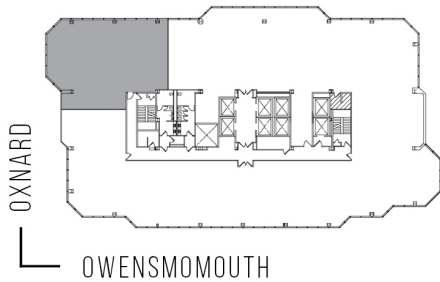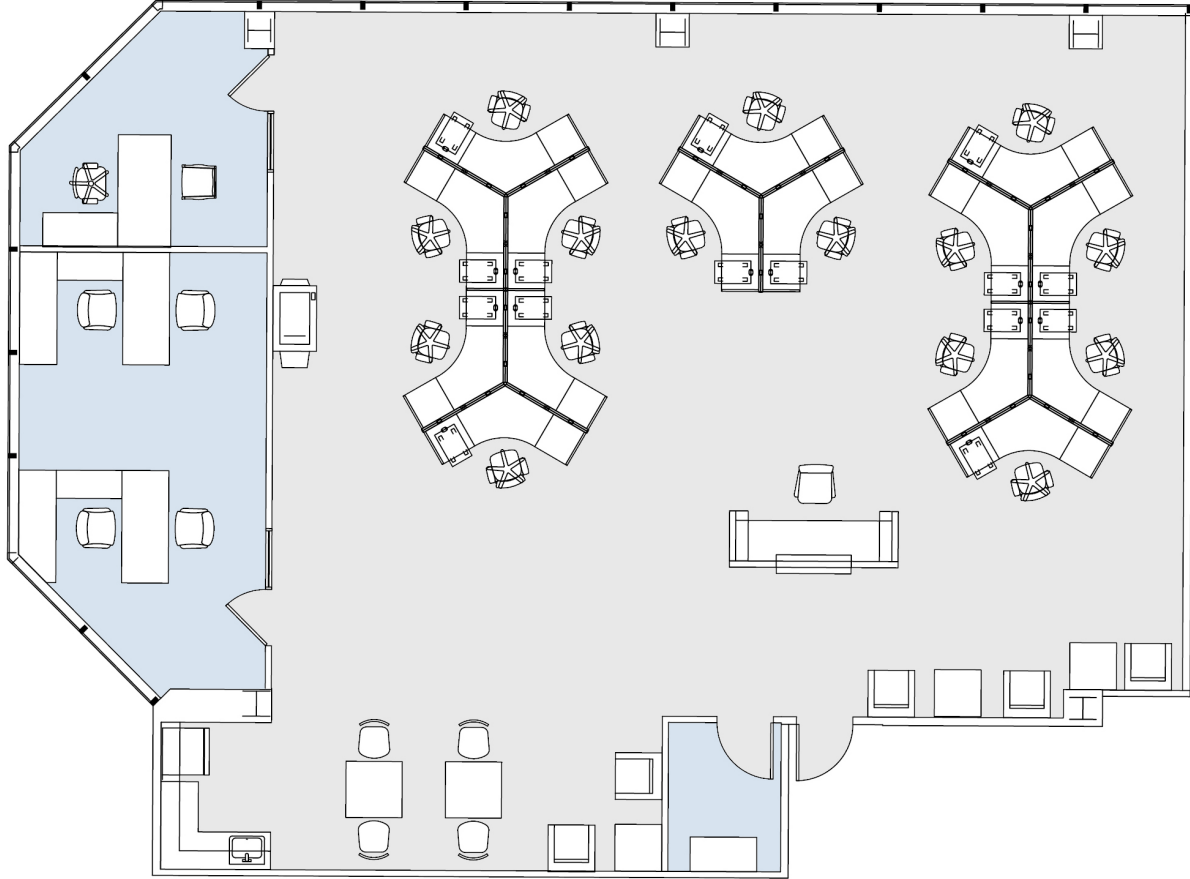

AS-BUILT CONFIGURATION

OFFICES:	2
RECEPTION:	1
KITCHEN:	1
IT ROOM:	1

ADJUSTED FOR SOCIAL DISTANCING
NOT TO SCALE
FURNITURE NOT INCLUDED

For more information, please contact:

310.255.7777
leasing@douglasemmett.com

**Douglas
Emmett**