
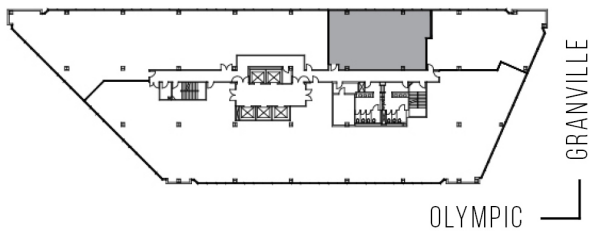


# 11835 OLYMPIC

WESTSIDE TOWERS EAST TOWER

SUITE 1125 | 2,120 RSF

SAWTELLE/WEST LA

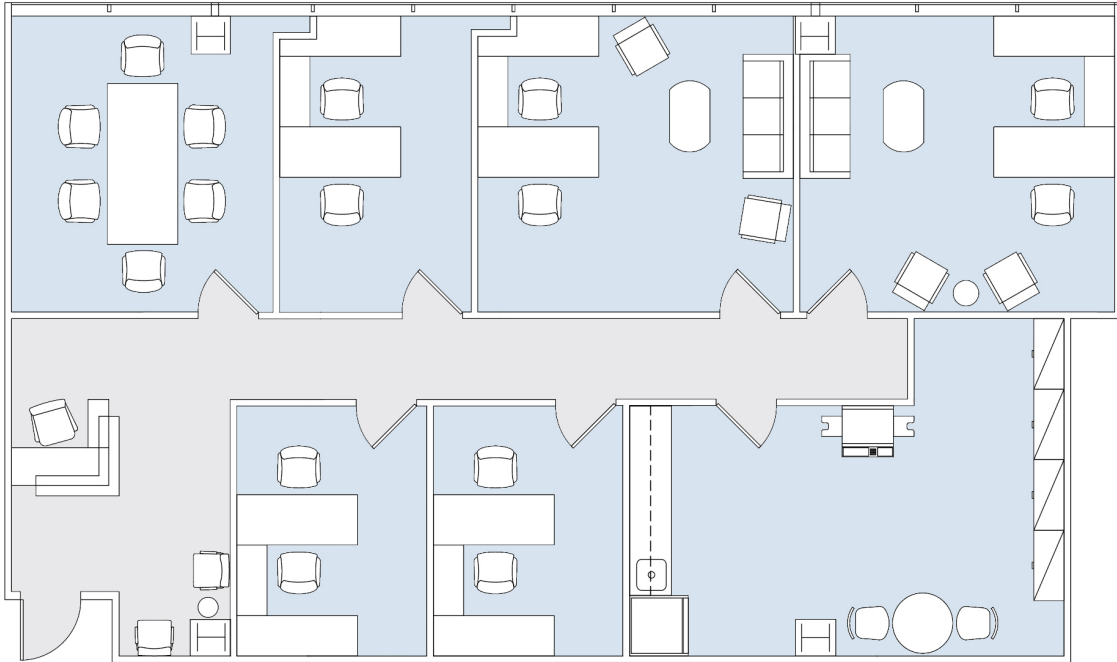

#### AS-BUILT CONFIGURATION

OFFICES:	5
CONFERENCE ROOM:	1
RECEPTION:	1
KITCHEN/ FILE ROOM:	1

ADJUSTED FOR SOCIAL DISTANCING  
NOT TO SCALE  
FURNITURE NOT INCLUDED

For more information, please contact:

310.255.7777  
leasing@douglasemmett.com

**Douglas  
Emmett**