



21550

WARNER CENTER TOWER - II

SUITE 990 | 3,031 RSF

WOODLAND HILLS

OXNARD STREET

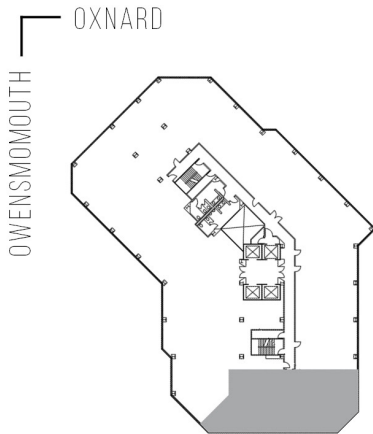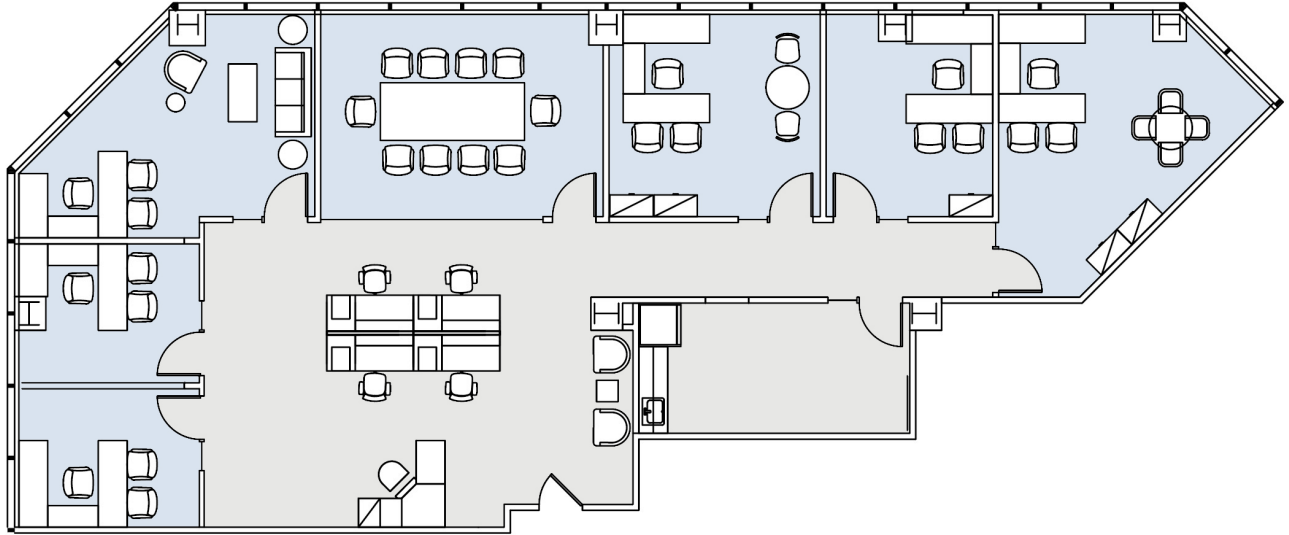

AS-BUILT CONFIGURATION

OFFICES:	6
CONFERENCE ROOM:	1
KITCHEN:	1
RECEPTION AREA:	1

NOT TO SCALE
FURNITURE NOT INCLUDED

For more information, please contact:

310.255.7777
leasing@douglasemmett.com

**Douglas
Emmett**