



11999

BRENTWOOD/SALTAIR

SUITE 220 | 2,134 RSF

BRENTWOOD-SAN VICENTE

SAN VICENTE

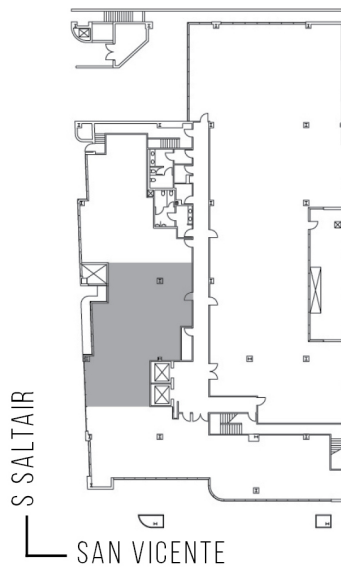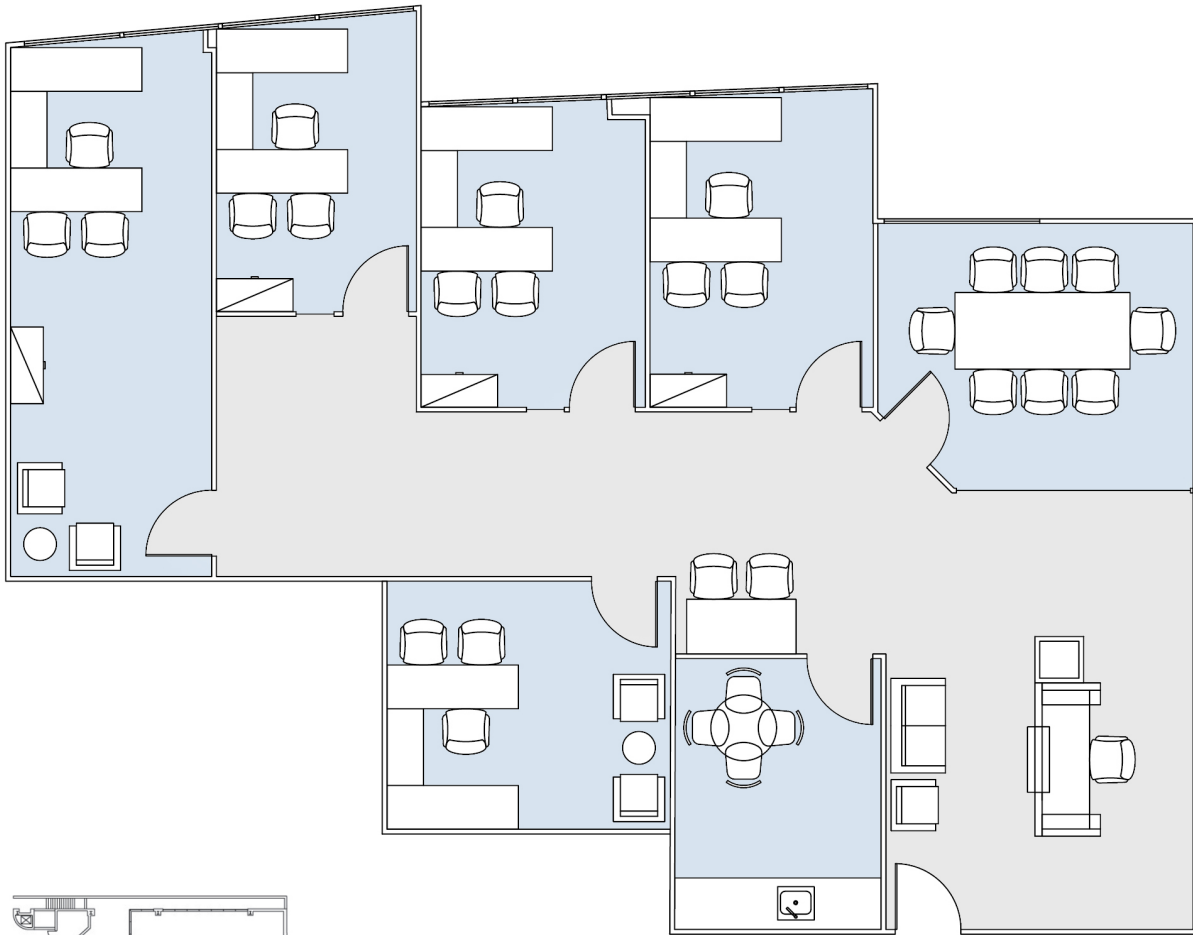

AS-BUILT CONFIGURATION

OFFICES:	5
CONFERENCE ROOM:	1
RECEPTION:	1
KITCHEN:	1

NOT TO SCALE
FURNITURE NOT INCLUDED

For more information, please contact:

310.255.7777
leasing@douglasemmett.com

