



11726

BRENTWOOD EXECUTIVE PLAZA

SUITE 510 | 1,317 RSF

BRENTWOOD-SAN VICENTE

# SAN VICENTE

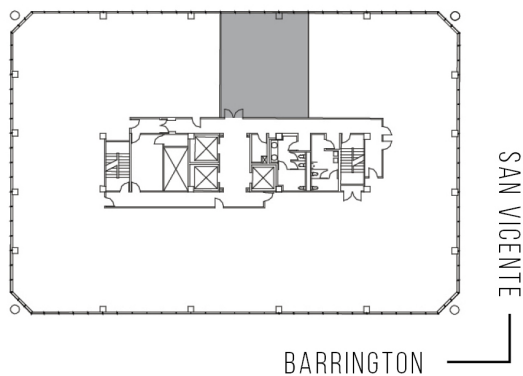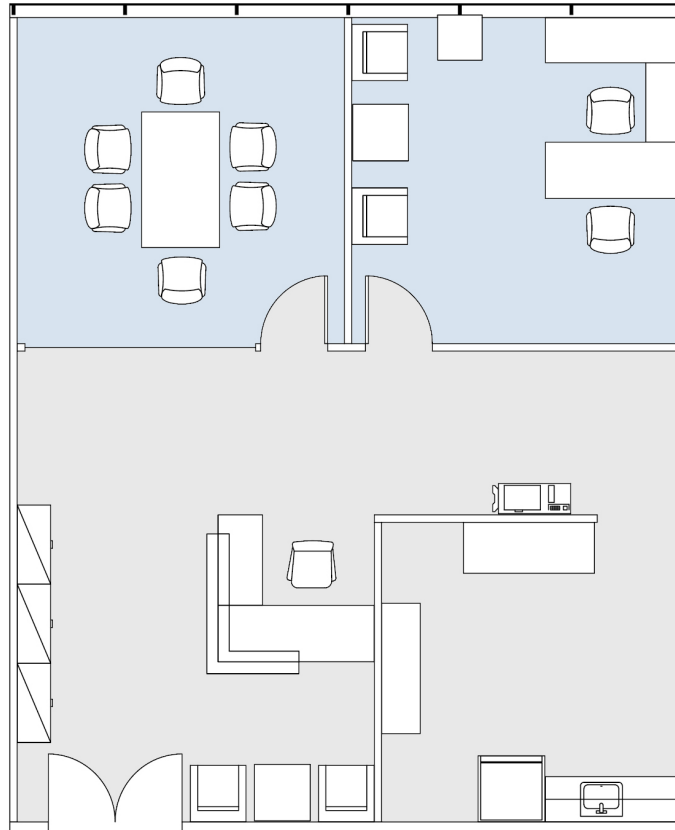

### AS-BUILT CONFIGURATION

OFFICES:	1
CONFERENCE ROOM:	1
RECEPTION:	1
KITCHEN:	1

ADJUSTED FOR SOCIAL DISTANCING  
NOT TO SCALE  
FURNITURE NOT INCLUDED

For more information, please contact:

310.255.7777  
leasing@douglasemmett.com

**Douglas  
Emmett**