
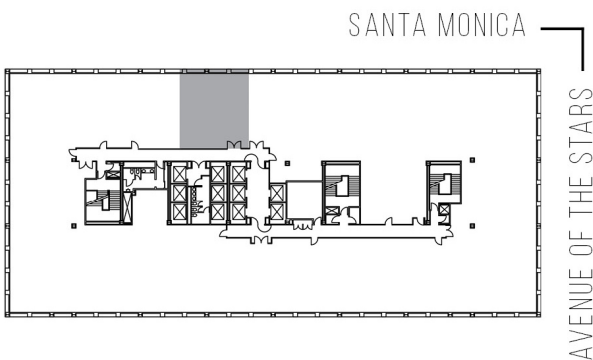


1901

SUITE 920 | 1,661 RSF

CENTURY CITY

AVENUE OF THE STARS

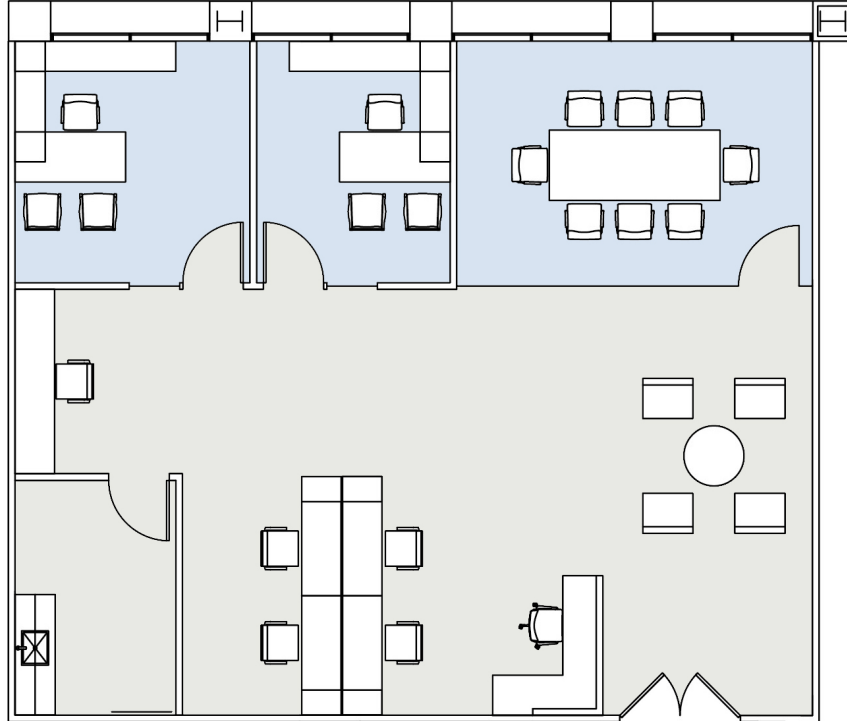

AS-BUILT CONFIGURATION

OFFICES:	2
RECEPTION:	1
CONFERENCE ROOM:	1
KITCHEN:	1

NOT TO SCALE
FURNITURE NOT INCLUDED

For more information, please contact:

310.255.7777
leasing@douglasemmett.com

**Douglas
Emmett**