



11726

BRENTWOOD EXECUTIVE PLAZA

SUITE 212 | 1,421 RSF

BRENTWOOD-SAN VICENTE

# SAN VICENTE

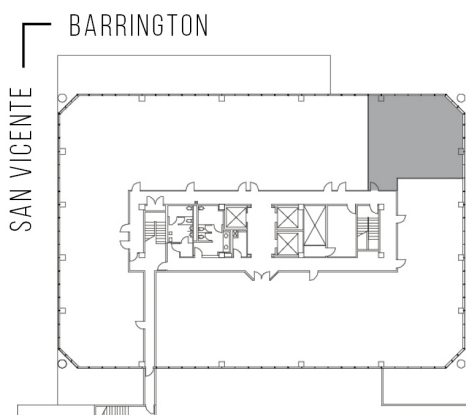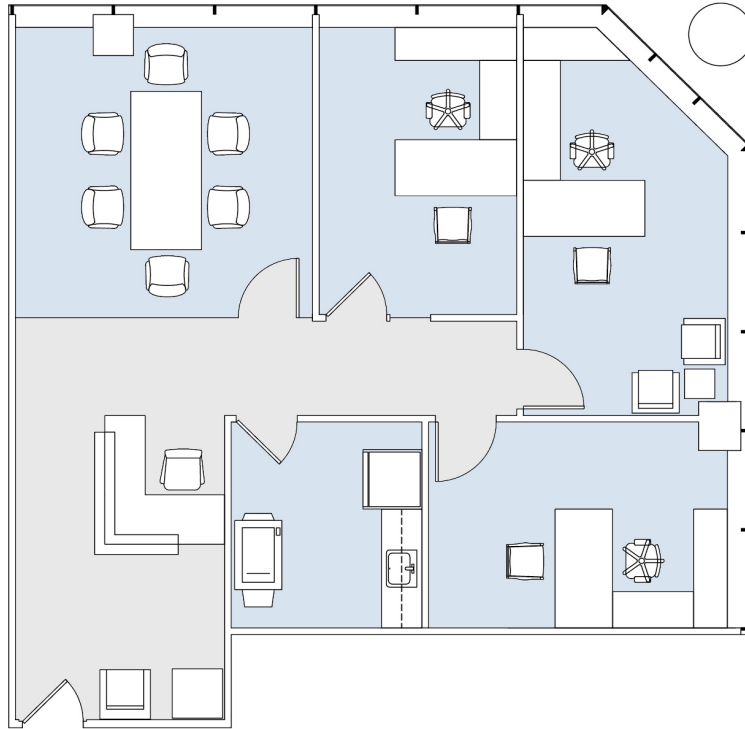

### AS-BUILT CONFIGURATION

OFFICE:	3
CONFERENCE ROOM:	1
RECEPTION AREA:	1
KITCHEN:	1

ADJUSTED FOR SOCIAL DISTANCING  
NOT TO SCALE  
FURNITURE NOT INCLUDED

For more information, please contact:

310.255.7777  
leasing@douglasemmett.com

**Douglas  
Emmett**