
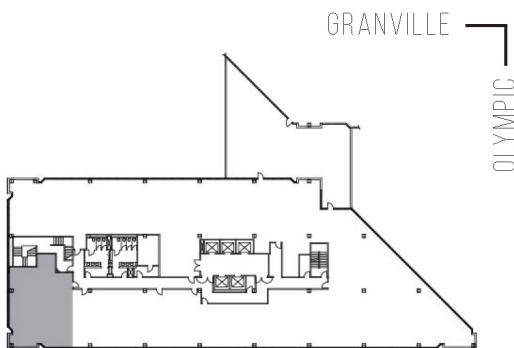


# 11845 OLYMPIC

WESTSIDE TOWERS WEST TOWER

SUITE 515 | 1,914 RSF

SAWTELLE/WEST LA

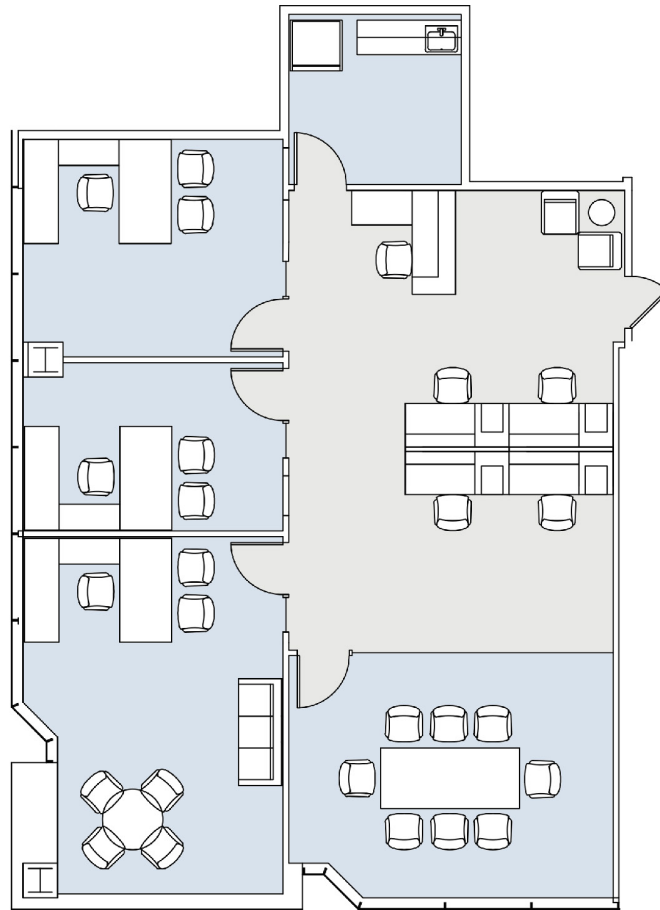

#### AS-BUILT CONFIGURATION

OFFICES:	3
WORKSTATIONS:	4
RECEPTION:	1
CONFERENCE ROOM:	1
KITCHEN:	1

NOT TO SCALE  
FURNITURE NOT INCLUDED

For more information, please contact:

310.255.7777  
leasing@douglasemmett.com

**Douglas  
Emmett**