
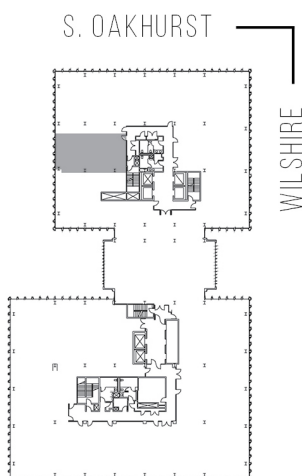


# 9100 WILSHIRE

9100 WILSHIRE WEST TOWER

SUITE W0210 | 1,302 RSF

BEVERLY HILLS

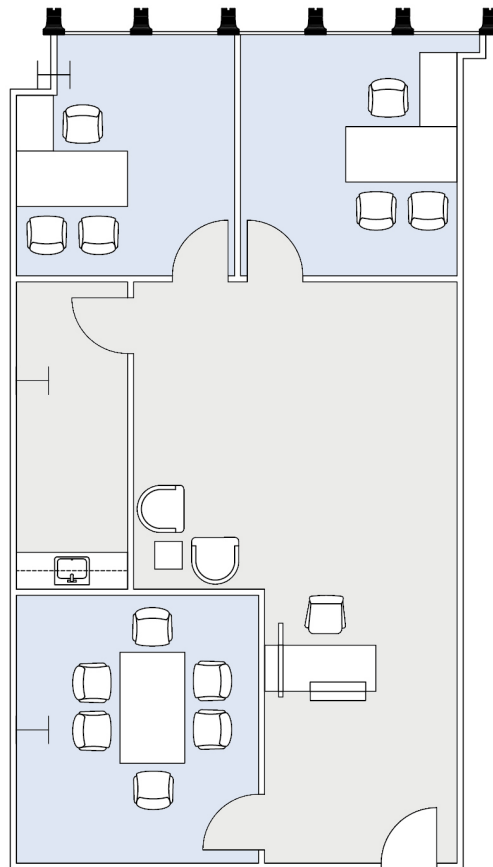

#### AS-BUILT CONFIGURATION

OFFICES:	2
CONFERENCE ROOM:	1
KITCHEN:	1
RECEPTION AREA :	1

NOT TO SCALE  
FURNITURE NOT INCLUDED

For more information, please contact:

310.255.7777  
leasing@douglasemmett.com

**Douglas  
Emmett**