



6320

THE TRILLIUM - EAST TOWER

SUITE 640 | 2,386 RSF

WOODLAND HILLS

CANOGA AVENUE

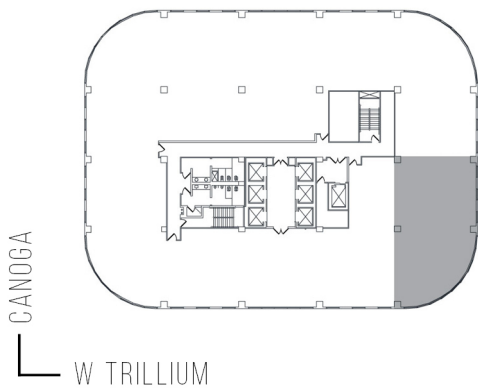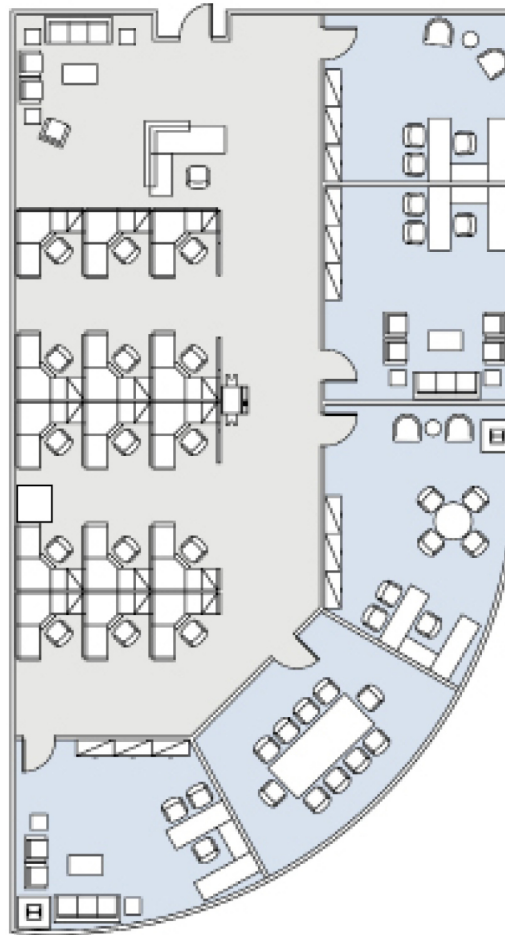

AS-BUILT CONFIGURATION

| | |
|------------------|----|
| OFFICES: | 4 |
| WORKSTATIONS: | 15 |
| RECEPTION: | 1 |
| CONFERENCE ROOM: | 1 |

NOT TO SCALE
FURNITURE NOT INCLUDED

For more information, please contact:

310.255.7777
leasing@douglasemmett.com

**Douglas
Emmett**