



6300

THE TRILLIUM - WEST TOWER

SUITE 1320 | 1,858 RSF

WOODLAND HILLS

CANOGA AVENUE

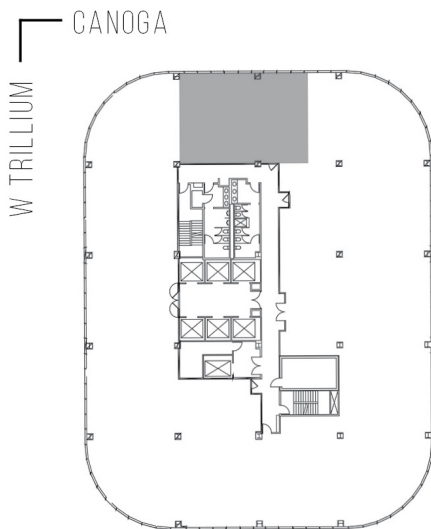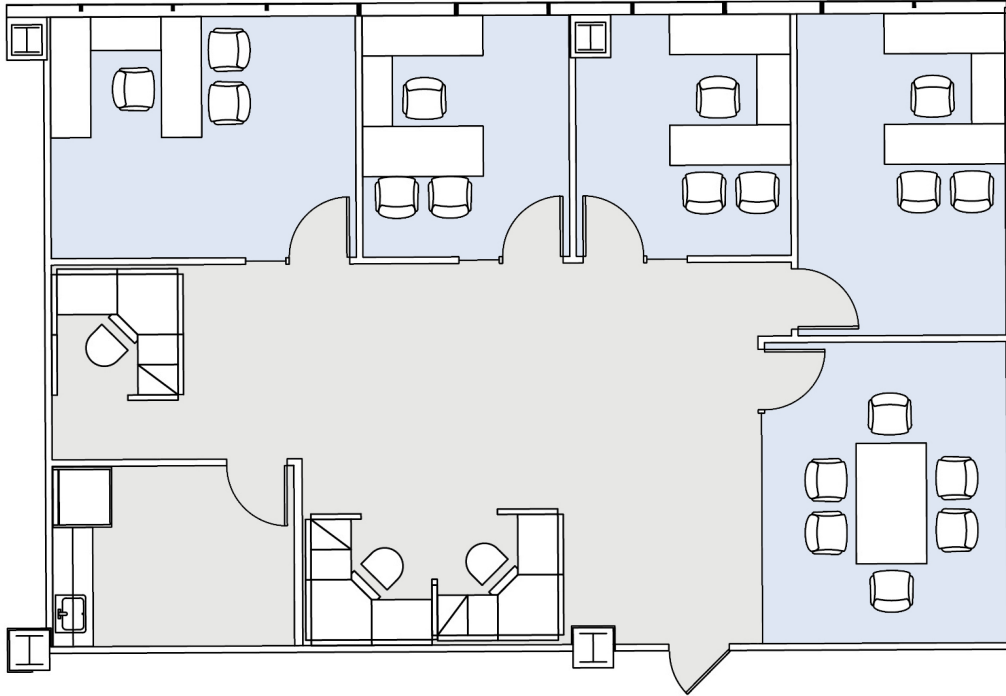

AS-BUILT CONFIGURATION

OFFICES:	4
CONFERENCE ROOM:	1
KITCHEN:	1

NOT TO SCALE
FURNITURE NOT INCLUDED

For more information, please contact:

310.255.7777
leasing@douglasemmett.com

**Douglas
Emmett**