



11999

BRENTWOOD/SALTAIR

SUITE 240 | 1,768 RSF

BRENTWOOD-SAN VICENTE

# SAN VICENTE

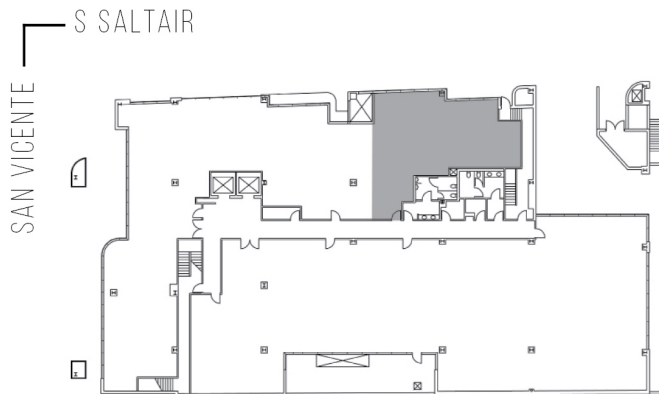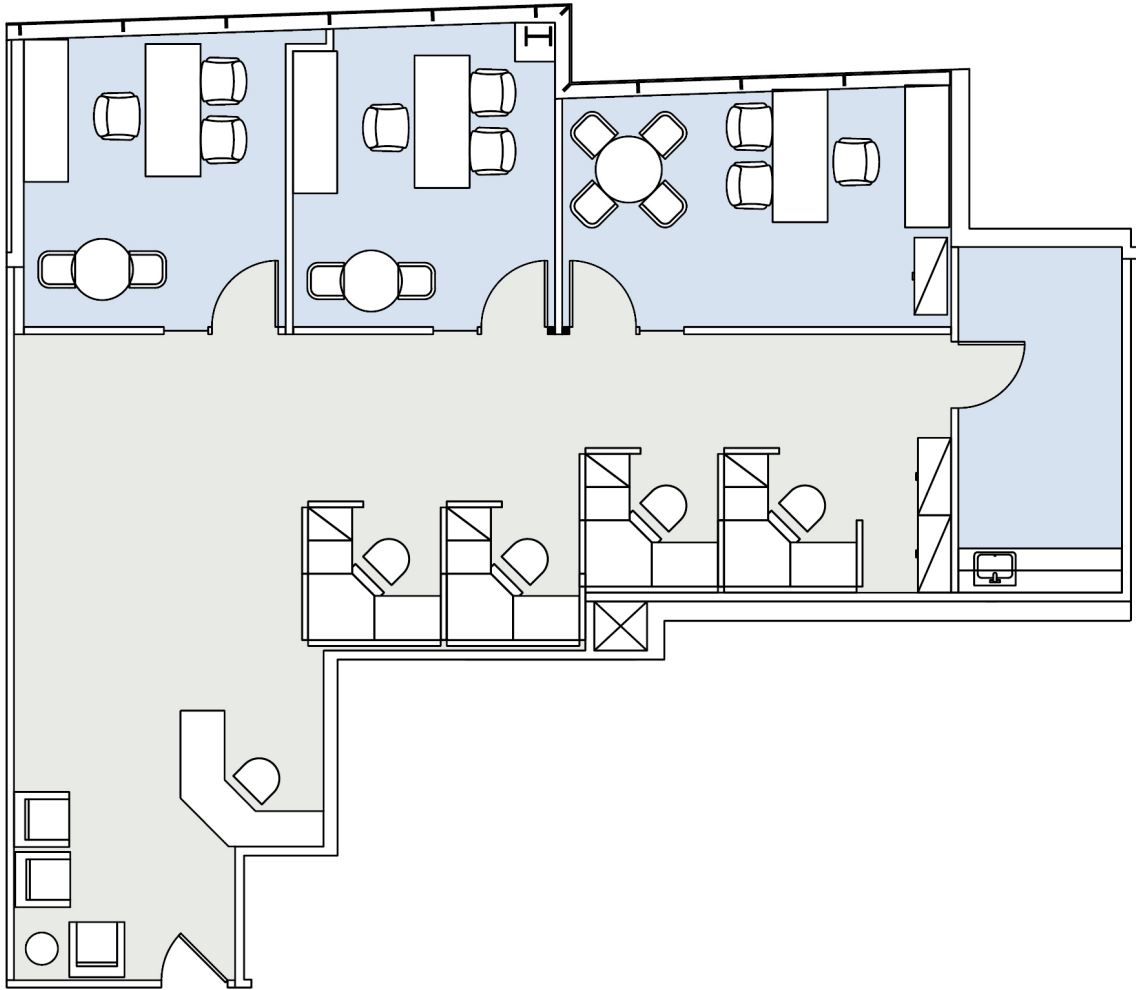

### AS-BUILT CONFIGURATION

OFFICES:	3
KITCHEN:	1
RECEPTION:	1

NOT TO SCALE  
FURNITURE NOT INCLUDED

For more information, please contact:

310.255.7777  
leasing@douglasemmett.com

**Douglas  
Emmett**