



15260

VALLEY EXECUTIVE TOWER

SUITE 1710 | 1,859 RSF

SHERMAN OAKS/ENCINO

VENTURA

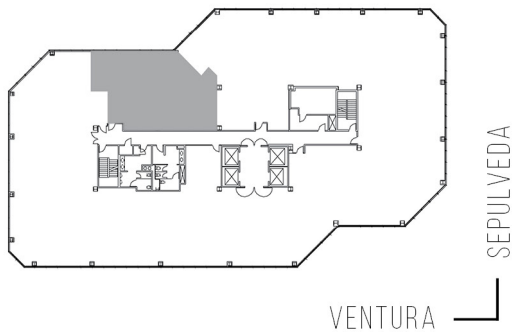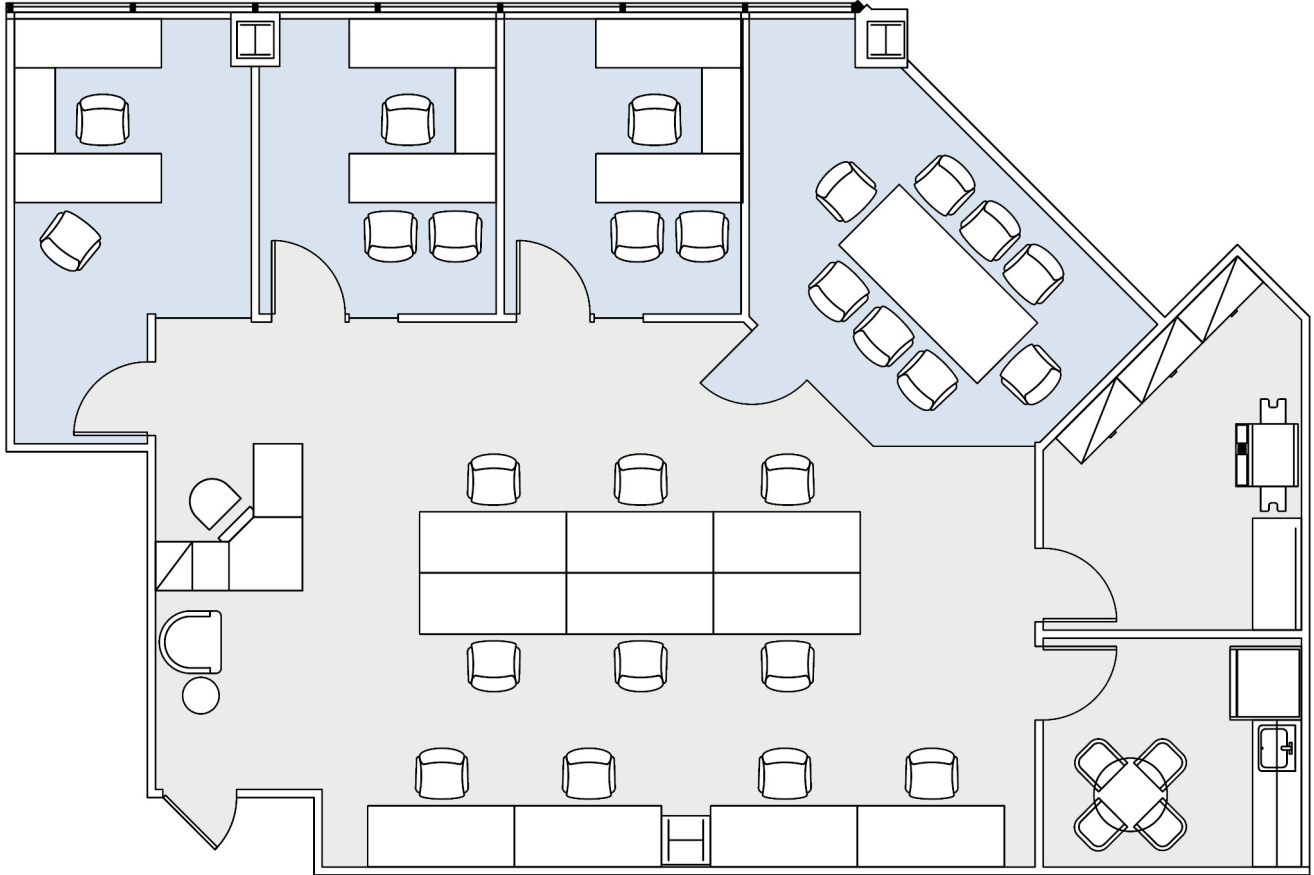

AS-BUILT CONFIGURATION

OFFICES:	3
RECEPTION:	1
CONFERENCE ROOM:	1
KITCHEN:	1
COPY/STORAGE:	1

NOT TO SCALE
FURNITURE NOT INCLUDED

For more information, please contact:

310.255.7777
leasing@douglasemmett.com

**Douglas
Emmett**