
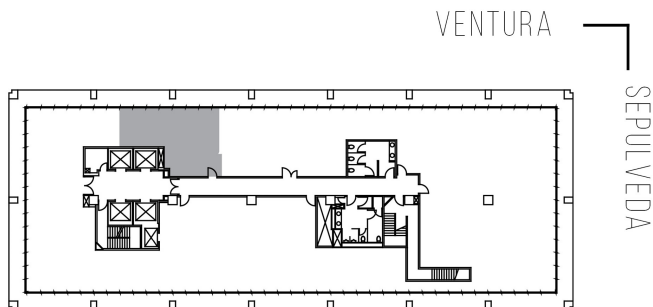


15233  
VENTURA

VALLEY OFFICE PLAZA

SUITE 230 | 800 RSF

SHERMAN OAKS/ENCINO

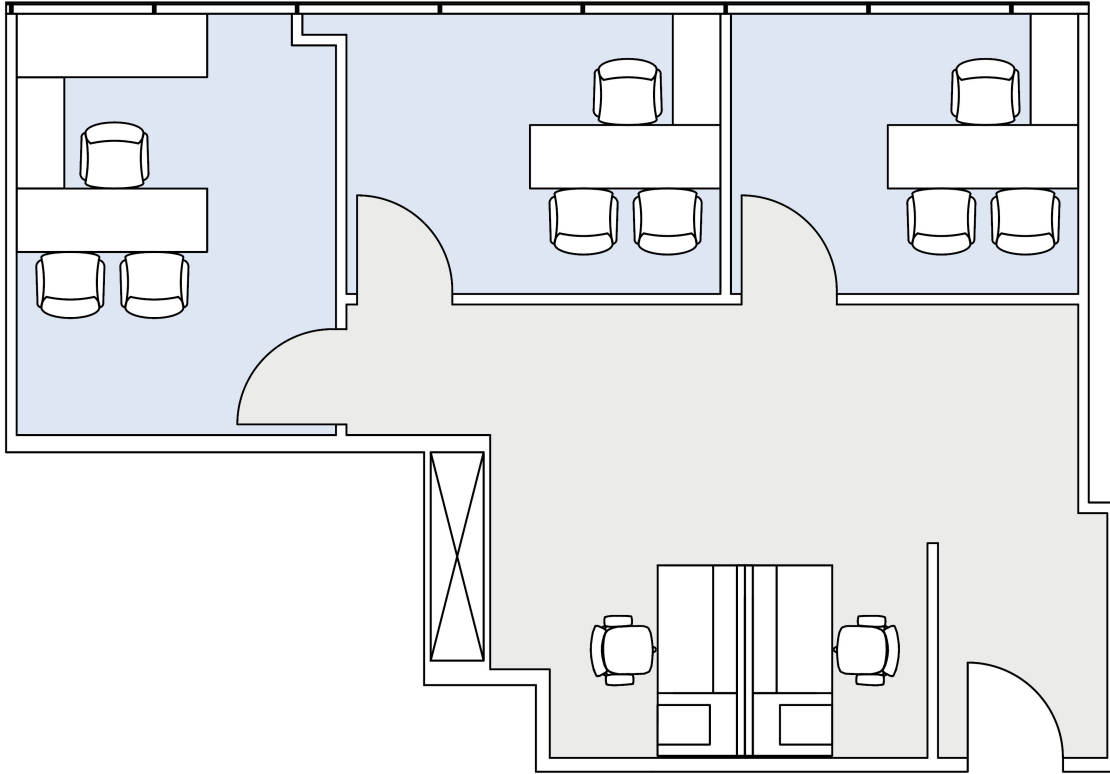

AS-BUILT CONFIGURATION

OFFICES: 3

NOT TO SCALE  
FURNITURE NOT INCLUDED

For more information, please contact:

310.255.7777  
leasing@douglasemmett.com

**Douglas  
Emmett**