
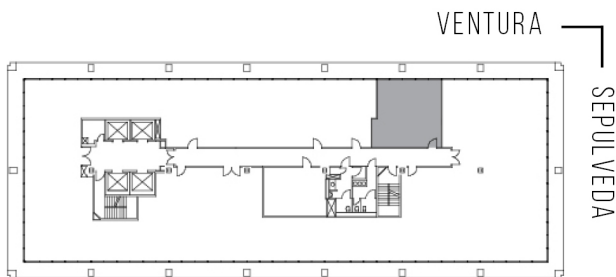


# 15233 VENTURA

VALLEY OFFICE PLAZA

SUITE 1005 | 701 RSF

SHERMAN OAKS/ENCINO

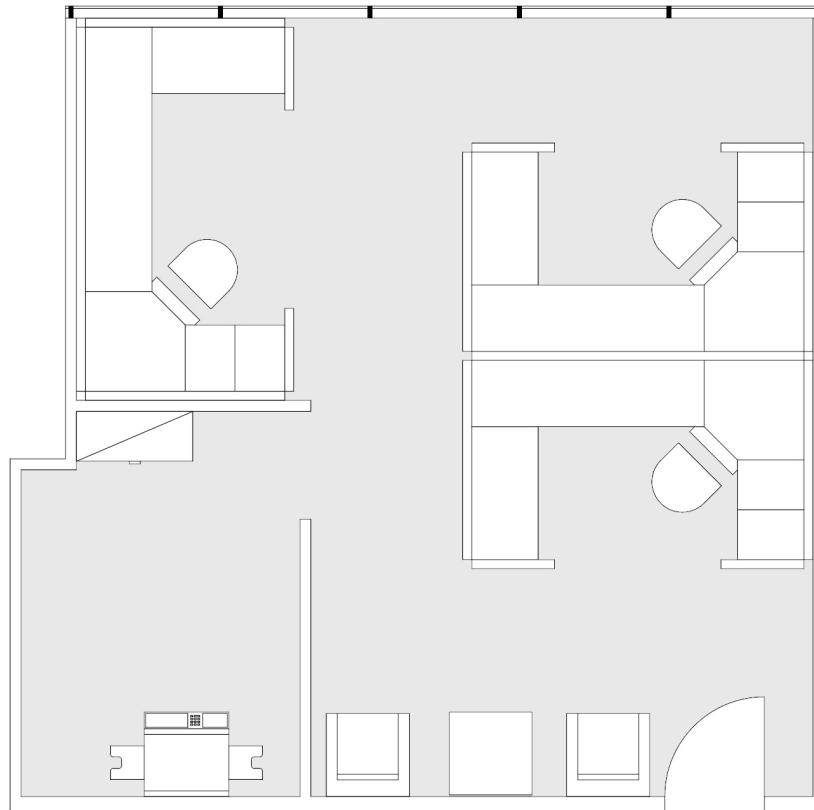

#### AS-BUILT CONFIGURATION

OPEN OFFICE:	1
RECEPTION:	1
STORAGE AREA:	1

ADJUSTED FOR SOCIAL DISTANCING  
NOT TO SCALE  
FURNITURE NOT INCLUDED

For more information, please contact:

310.255.7777  
leasing@douglasemmett.com

**Douglas  
Emmett**