


11812

CORAL PLAZA

SUITE 130 | 11,296 RSF

BRENTWOOD-SAN VICENTE

# SAN VICENTE

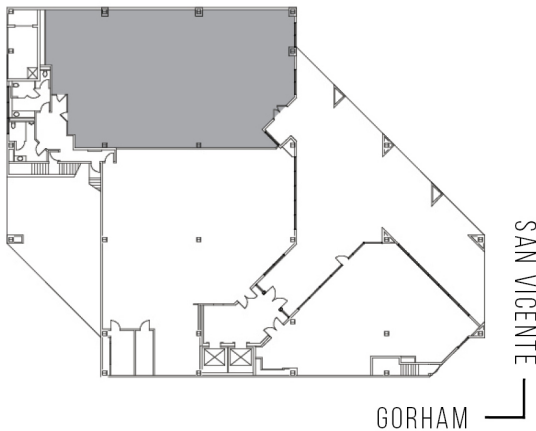

#### AS-BUILT CONFIGURATION

OFFICES:	10
CONFERENCE ROOMS:	2
RECEPTION:	1
STORAGE CLOSETS:	4

ADJUSTED FOR SOCIAL DISTANCING  
NOT TO SCALE  
FURNITURE NOT INCLUDED

For more information, please contact:

310.255.7777  
leasing@douglasemmett.com

**Douglas  
Emmett**