


1100

WESTWOOD CENTER

SUITE 705 | 3,242 RSF

WESTWOOD

# GLENDON AVENUE

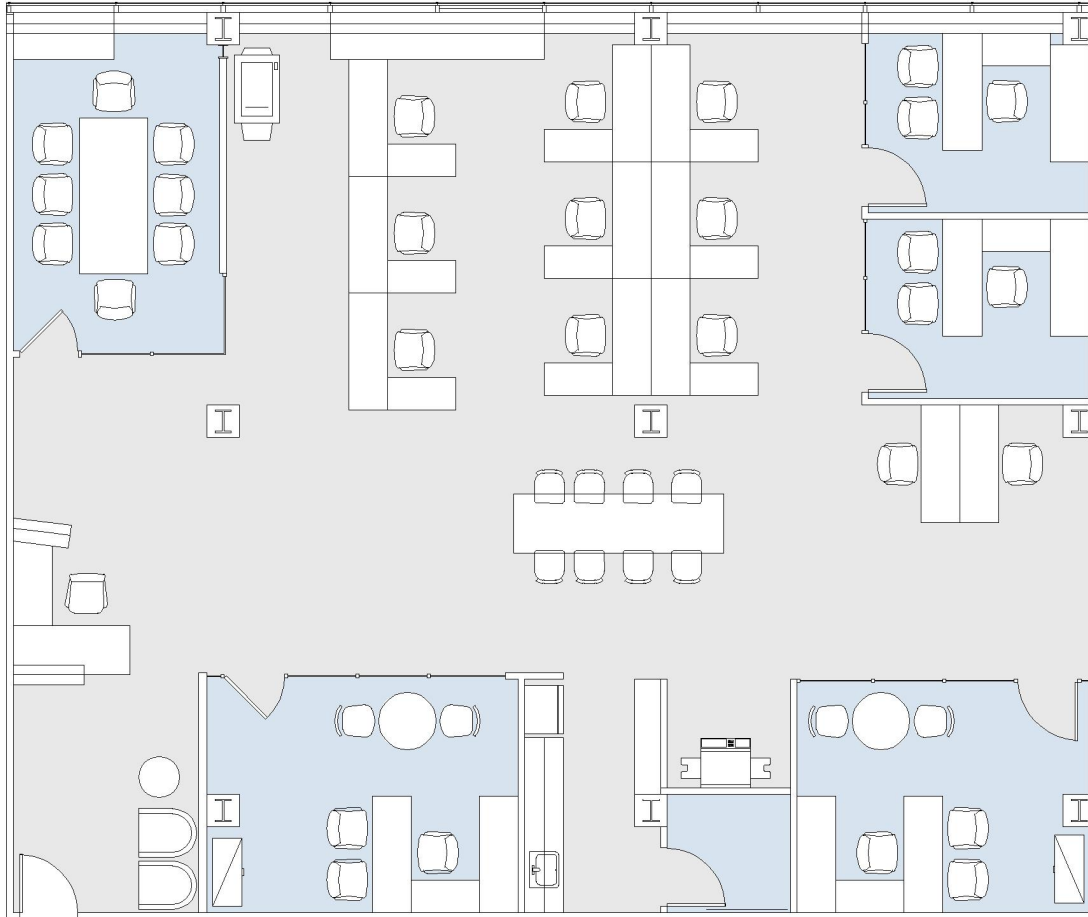


## AS-BUILT CONFIGURATION

OFFICES:	4
CONFERENCE ROOM:	1
RECEPTION:	1
KITCHEN:	1
IT ROOM:	1

NOT TO SCALE

FURNITURE NOT INCLUDED

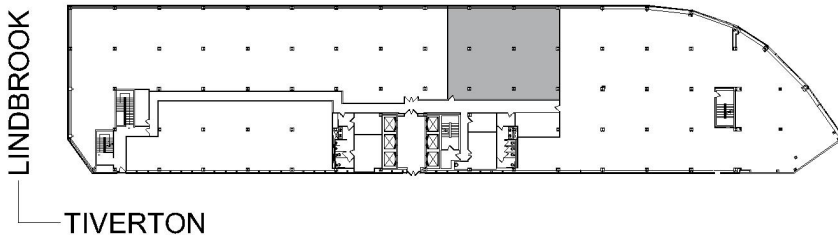

For more information, please contact:

310.255.7777  
leasing@douglasemmett.com

**Douglas  
Emmett**