



15165

COLUMBUS CENTER

SUITE 315 | 3,308 RSF

SHERMAN OAKS/ENCINO

VENTURA

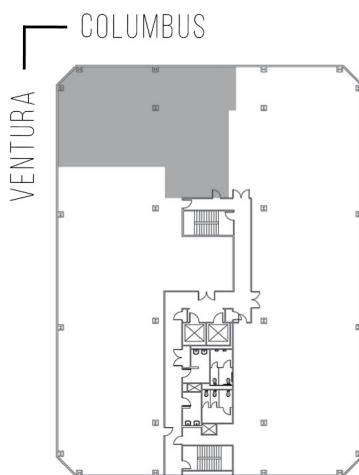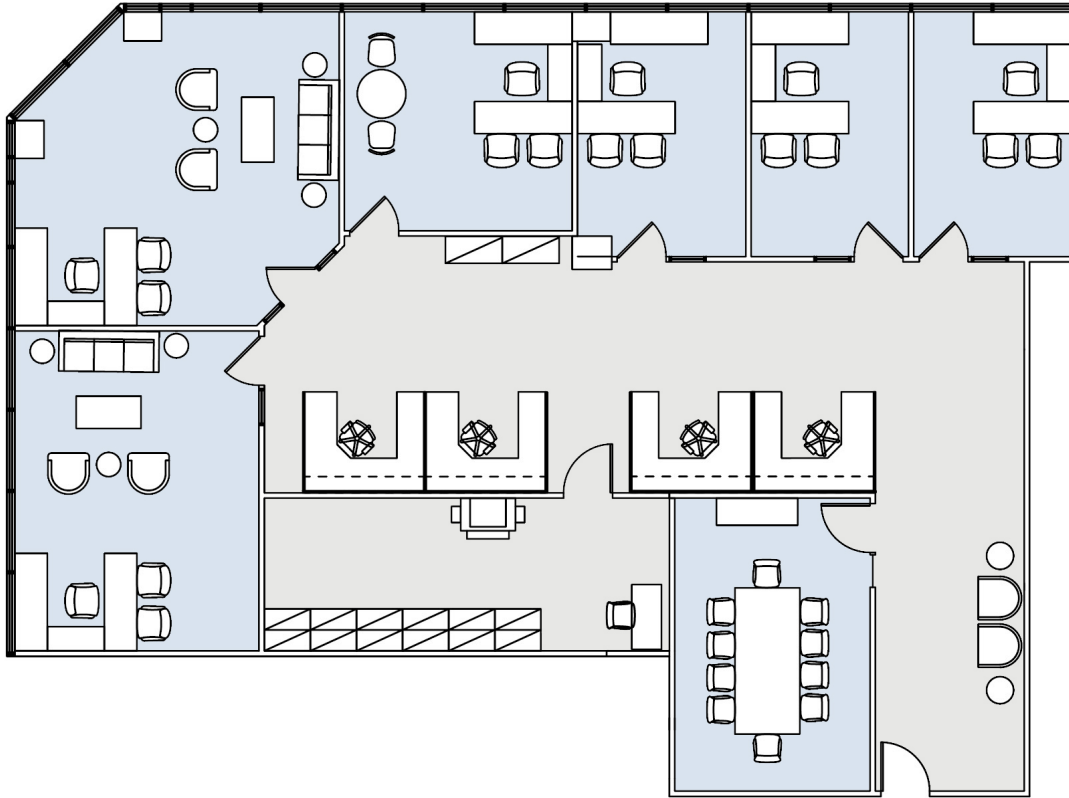

AS-BUILT CONFIGURATION

OFFICES:	6
CONFERENCE ROOM:	1
RECEPTION:	1
FILING ROOM:	1

NOT TO SCALE
FURNITURE NOT INCLUDED

For more information, please contact:

310.255.7777
leasing@douglasemmett.com

**Douglas
Emmett**