



21800

WARNER CENTER TOWER - V

SUITE 450 | 1,257 RSF

WOODLAND HILLS

OXNARD STREET

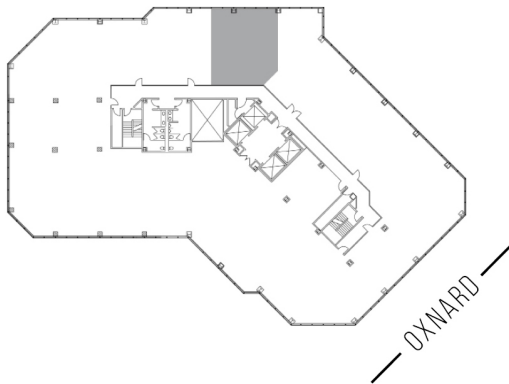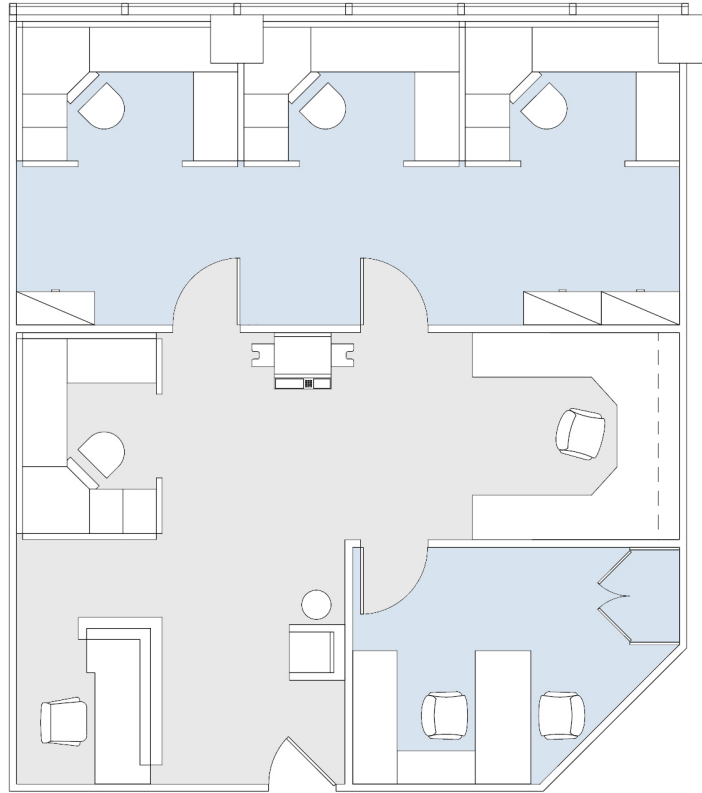

AS-BUILT CONFIGURATION

OFFICES:	1
OPEN OFFICE:	1
RECEPTION:	1

ADJUSTED FOR SOCIAL DISTANCING
NOT TO SCALE
FURNITURE NOT INCLUDED

For more information, please contact:

310.255.7777
leasing@douglasemmett.com

**Douglas
Emmett**