
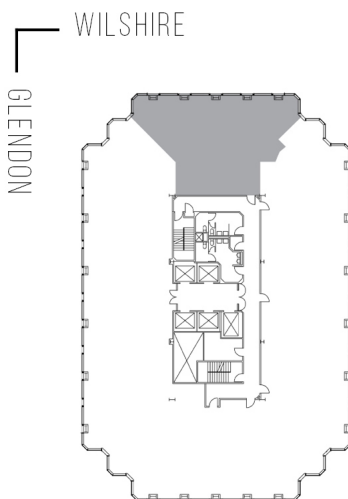


10866 WILSHIRE

WESTWOOD PLACE

SUITE 820 | 2,068 RSF

WESTWOOD

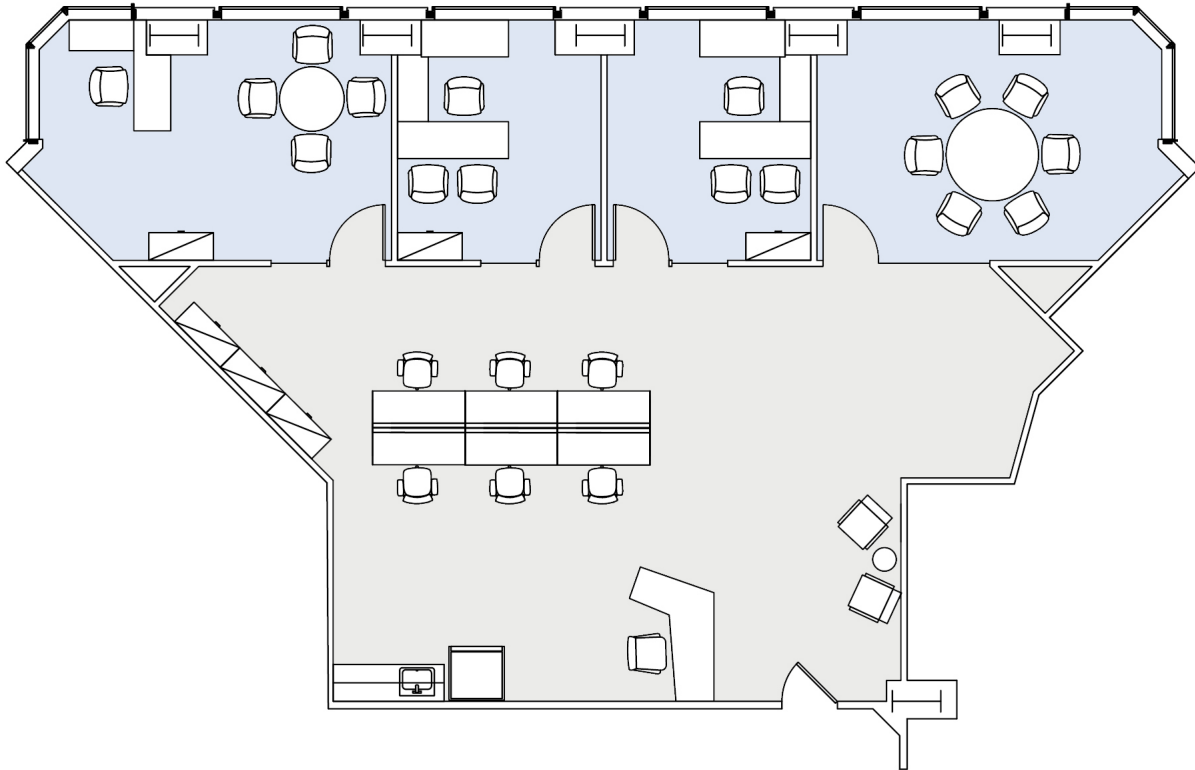

AS-BUILT CONFIGURATION

OFFICES:	3
RECEPTION:	1
CONFERENCE ROOM:	1
OPEN KITCHENETTE:	1

NOT TO SCALE
FURNITURE NOT INCLUDED

For more information, please contact:

310.255.7777
leasing@douglasemmett.com

**Douglas
Emmett**